


WELL PLUGGING RECORD

Give All Information Completely
Make Required Affidavit
Mail or Deliver Report to:
Conservation Division
State Corporation Commission
211 No. Broadway
Wichita, Kansas

NORTH

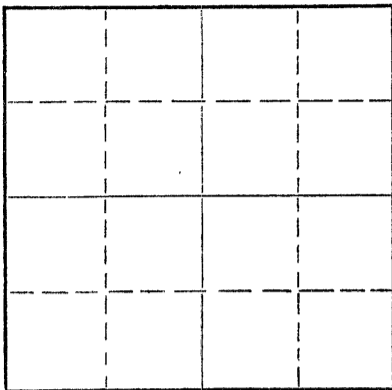

Locate well correctly on above
Section Plat

Rawlins County, Sec. 20 Twp. 1-S Rge. 34 (E) (W)
Location as "NE/CNW/SW" or footage from lines 147' E. of C NE NW
Lease Owner Pack Oil Co., Inc.
Lease Name Garver Well No. 2
Office Address 665 4th National Building - Wichita, Kansas
Character of Well (completed as Oil, Gas or Dry Hole) Dry Hole
Date well completed 3-18-64 19
Application for plugging filed 3-18-64 19
Application for plugging approved 3-18-64 19
Plugging commenced 3-18-64 19
Plugging completed 3-18-64 19
Reason for abandonment of well or producing formation Dry Hole

If a producing well is abandoned, date of last production 19
Was permission obtained from the Conservation Division or its agents before plugging was commenced? yes

Name of Conservation Agent who supervised plugging of this well W. L. Nichols - Moreland, Kansas
Producing formation Depth to top Bottom Total Depth of Well 4370 Feet
Show depth and thickness of all water, oil and gas formations.

OIL, GAS OR WATER RECORDS

CASING RECORD

FORMATION	CONTENT	FROM	TO	SIZE	PUT IN	PULLED OUT

Describe in detail the manner in which the well was plugged, indicating where the mud fluid was placed and the method or methods used in introducing it into the hole. If cement or other plugs were used, state the character of same and depth placed, from feet to feet for each plug set.

1st plug @ 600' w/20 sacks
2nd plug @ 320' w/20 sacks
3rd plug @ 40' w/10 sacks

RECEIVED
STATE CORPORATION COMMISSION

APR 7 1964

4-7-64
CONSERVATION DIVISION
Wichita, Kansas

(If additional description is necessary, use BACK of this sheet)

Name of Plugging Contractor Murfin Drilling Company
Address 617 Union Center - Wichita 2, Kansas

STATE OF Kansas COUNTY OF Sedgwick, ss.
C. Robert Buford (employee of owner) or (owner or operator) of the above-described well, being first duly sworn on oath, says: That I have knowledge of the facts, statements, and matters herein contained and the log of the above-described well as filed and that the same are true and correct. So help me God.

(Signature) C. Robert Buford
Murfin Drlg. Co. - 617 Union Center - Wichita, Ks.
(Address)

SUBSCRIBED AND SWORN TO before me this 1st day of April, 19 64

My commission expires ADELA MIZENER, Notary Public
My commission expires November 5, 1966

Notary Public.


WELL LOG

15-153-30088-00-00-

COMPANY Pack Oil Co., Inc.
FARM Garver NO. ~~One~~ ^{Two} (2)
RIG. NO. 16
TOTAL DEPTH 4370'
COMM. 3-10-64 COMP. 3-18-64
SHOT OR TREATED
CONTRACTOR Murfin Drilling Company
ISSUED

SEC. 20 T. 1S R. 34W
LOC. C NE NW

COUNTRY Rawlins
KANSAS

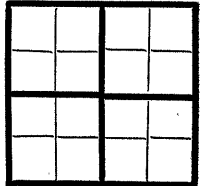

CASINO
20 10
15 8 5/8" 331' w/250 sacks
12 6
13 5

ELEVATION

PRODUCTION D & A

FIGURES INDICATE BOTTOM OF FORMATIONS

300 Surface
335 Blue Shale
1860 Shale
2545 Sand & Shale
2675 Shale & Sand
2775 Sand & Shale
2900 Shale, Sand & Gypsum
3035 Red Bed
3074 Anhydrite
3100 Shale & Shells
3300 Shale & Sand
3645 Shale & Lime
4080 Lime & Shale
4370 Lime
4370 RTD

RECEIVED
STATE CORPORATION COMMISSION

APR 7 1964
4-7-64
CONSERVATION DIVISION
Wichita, Kansas

State of KANSAS }
County of SEDGWICK } ss:

I, C. Robert Buford of the Murfin Drilling Company

upon oath state that the above and foregoing is a true and correct copy of the log of the Garver #1 well.

MURFIN DRILLING COMPANY

By: C. Robert Buford
C. Robert Buford

Subscribed and sworn to before me this 1st day of April 19 64

My Commission Expires: ADELA MIZENER, Notary Public

My commission expires November 5, 1966

Adela Mizener
NOTARY PUBLIC