

STATE OF KANSAS  
STATE CORPORATION COMMISSION

15-153-05187-00-00

WELL PLUGGING RECORD

Give All Information Completely  
Make Required Affidavit  
Mail or Deliver Report to:  
Conservation Division  
State Corporation Commission  
211 No. Broadway  
Wichita, Kansas

NORTH

		x #1	
Section 19			

Locate well correctly on above  
Section Plat

Rawlins County. Sec. 19 Twp. 1S Rge. 34 (E) (W)  
Location as "NE/CNW/SW" or footage from lines Center NW/4 NE/4 NE/4  
Lease Owner Skelly Oil Company  
Lease Name A. E. Skolout Well No. 1  
Office Address P. O. Drawer 310, Sterling, Colorado  
Character of Well (completed as Oil, Gas or Dry Hole) Oil  
Date well completed November 16, 19 59  
Application for plugging filed May 26, 19 60  
Application for plugging approved May 31, 19 60  
Plugging commenced August 13, 19 60  
Plugging completed August 15, 19 60  
Reason for abandonment of well or producing formation Non-Profitable to operate.  
If a producing well is abandoned, date of last production December 1, 19 59  
Was permission obtained from the Conservation Division or its agents before plugging was commenced? Yes

Name of Conservation Agent who supervised plugging of this well A. D. Fabricius  
Producing formation Lansing Lime Depth to top 4078' Bottom 4370' Total Depth of Well 4390' Feet  
Show depth and thickness of all water, oil and gas formations.

OIL, GAS OR WATER RECORDS

CASING RECORD

FORMATION	CONTENT	FROM	TO	SIZE	PUT IN	PULLED OUT
Council Grove	Dry	3432'	3878'	8-5/8"OD	440'	0
Topeka Lime	Dry	3878'	4023'	5-1/2"OD	4385'	2768'
Heebner Shale	Dry	4023'	4028'			
Leavenworth	Dry	4028'	4078'			
Lansing Lime	Oil	4078'	4370'			
Marmaton	Dry	4370'	4390'			

Produced from Lansing formation, Casing perforations 4185' - 4191'.

Describe in detail the manner in which the well was plugged, indicating where the mud fluid was placed and the method or methods used in introducing it into the hole. If cement or other plugs were used, state the character of same and depth placed, from \_\_\_\_\_ feet to \_\_\_\_\_ feet for each plug set.

4317' - 4307' - Spotted 10 gallons of gravel.  
4307' - 4283' - Spotted 3 sacks regular cement.  
4283' - 446' - 10# drilling mud.  
446' - 441' - Spotted 13 gallons of gravel.  
441' - 364' - Spotted 25 sacks regular cement.  
364' - 40' - 10# drilling mud.  
40' - 35' - Spotted 13 gallons of gravel.  
35' - 7' - Spotted 10 sacks regular cement.  
7' - Ground Level - Dirt.

RECEIVED  
STATE CORPORATION COMMISSION

AUG 29 1960

CONSERVATION DIVISION  
Wichita, Kansas

(If additional description is necessary, use BACK of this sheet)

Name of Plugging Contractor Donnelly Casing Pulling Company  
Address Sterling, Colorado

8-29-960

STATE OF Colorado, COUNTY OF Logan, ss.  
K. S. Lee (employee of owner) or (owner/operator) of the above-described

well, being first duly sworn on oath, says: That I have knowledge of the facts, statements, and matters herein contained and the log of the above-described well as filed and that the same are true and correct. So help me God.

(Signature) K. S. Lee

P. O. Drawer 310, Sterling, Colorado  
(Address)

SUBSCRIBED AND SWORN TO before me this 19th day of August, 19 60


Ralph E. Felix Jr  
Notary Public.

My commission expires My Commission expires June 26, 1961



15-153-05157-00-00

# SKELLY OIL COMPANY

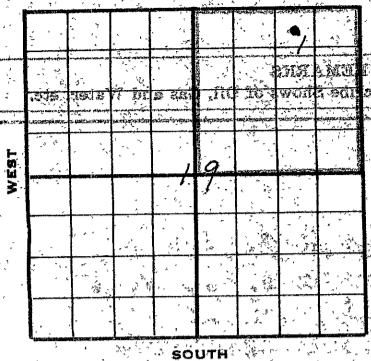

**Well Record**

Lease Name and No. A. E. Skelout Well No. 1 Elev. 3178' BH

Lease Description NE/4 Section 19-15-34W, Nowlin County, Kansas (160 Acres)

Location made Sept. 21, 19 59 by C. W. Burt

330 feet from North line 990 feet from East line NE/4

300 feet from South line 800 feet from West line of Sec. 19

Work com'd 9/26 19 59 Rig comp'd 9/27 19 59 Drlg. com'd 9/27 19 59 Drlg. comp'd 10/13 19 59

Rig Contractor Claude Wentworth Drilling Co., Inc.

Drilling Contractor Claude Wentworth Drilling Co., Inc., Tulsa, Okla.

Rotary Drilling from 0' to 4390' Cable Tool Drilling from To complete to

Commenced Producing November 16, 19 59 Initial Prod. before shot or acid  Bbls.

Initial Prod. after shot or acid 300 potential of 25 barrels oil and 21 cu ft gas Bbls.

Dry Gas Well Press.  Volume  Cu. ft.

Casing Head Gas Pressure  Volume  Cu. ft.

Braden Head (8-5/8" 351' OD) Gas Pressure  Volume  Cu. ft.

Braden Head () Gas Pressure  Volume  Cu. ft.

PRODUCING FORMATION Lansing Lime Top 4185' Bottom 4191' TOTAL DEPTH 4390'

**CASING RECORD**

Size	Wt.	Thds.	Where Set	PULLED OUT			LEFT IN			KIND	Cond'n	CEMENTING	
				Jts.	Feet	In.	Jts.	Feet	In.			Sacks Used	Method Employed
8-5/8"	22.7	53	446				11	440	0	Arco 30	A	300	Hallib. 4422' 0"
5-1/2"	14.8	82	4369				143	4385	0	J55 12 50 A	A	250	Hallib. 4422' 0"
(8-5/8" casing cut off 4' below ground level, and 5 1/2" cut off at ground level)													
5 1/2" casing perforations open:													
Above PB TD: 4185'-4191' with 24 holes													
Below PB TD: 4234'-38"/16, 4267'-4272"/20, 4311'-4320"/36 holes													

Liner Set at  Length  Perforated at

Liner Set at  Length  Perforated at

Packer Set at  Size and Kind

Packer Set at  Size and Kind

**SHOT OR ACID TREATMENT RECORD**

	FIRST	SECOND	THIRD	FOURTH
Date	<u>10/22/59</u>	<u>10/23/59</u>	<u>10/25/59</u>	
Acid Used				
Size Shot	<u>250</u>	<u>250</u>	<u>750</u>	
Shot Between	<u>4311 Ft. and 4320 Ft.</u>	<u>4181 Ft. and 4191 Ft.</u>	<u>4181 Ft. and 4191 Ft.</u>	
Size of Shell	<u>1 1/2"</u>	<u>1 1/2"</u>	<u>1 1/2"</u>	<u>For remaining treatments</u>
Put in by (Co.)	<u>Halliburton</u>	<u>Halliburton</u>	<u>Halliburton</u>	<u>see remarks</u>
Length anchor				
Distance below Casg				
Damage to Casing or Casing Shoulder				

**SIGNIFICANT GEOLOGICAL FORMATIONS**

NAME	Top	Bottom	GAS		OIL		REMARKS
			From	To	From	To	
Council Grove	<u>3632'</u>						
Topoka Lime	<u>3678'</u>						
Reedner Shale	<u>4023'</u>						
Leavenworth	<u>4028'</u>						
Lansing Lime	<u>4076'</u>				<u>4185' 4191' Prod. thru seg. perf.</u>		
Barnston	<u>4370'</u>						

**CLEANING OUT RECORDS**

	DATE COMMENCED	DATE COMPLETED	PROD. BEFORE	PROD. AFTER	REMARKS
1st					See Reverse for other details.
2nd					" " " " "
3rd					" " " " "
4th					" " " " "

**PLUGGING BACK AND DEEPENING RECORDS**

	Date Commenced	Date Completed	No. Feet Plugged Back or Deepened	Prod. Before	Prod. After	REMARKS
1st						See Reverse for other details.
2nd						" " " " "
3rd						" " " " "
4th						" " " " "

(See Reverse for Record of Formation)

Y 7141 M 00

RECORD OF FORMATIONS

FORMATION	TOP	BOTTOM	REMARKS
Surface soil, rock and clay	0	370	Set and cemented 5-5/8" OD, 22.77, Arco S.S., S.I. steel casing (1 cond.) at 440' with 300 sacks of Fomix cement. Cement circulated. Finished 9:00 on 9/28/59.
Clay and shells	370	455	
Shale	455	2270	<p>TOP COUNCIL GROVE 3132'</p> <p>TOP TOPKAI LINE 1878'</p> <p>TOP HERRIN 1023'</p> <p>TOP LEAVENWORTH 1025'</p> <p>TOP LANSING LINE 4078'</p>
Shale and pyrites	2270	2455	
Shale	2455	2540	
Shale, pyrites and sand	2540	2670	
Shale, pyrites and gyp	2670	2740	
Shale	2740	3145	
Shale and lime	3145	3984	
Lime	3984	4078	
Lime, buff to medium crystalline, vuggy and fossiliferous	4078	4095	Good porosity, fair spotted stain, show of free oil.
Lime	4095	4097	
Sand, tan to light gray, medium grained quartzitic	4097	4102	Fair porosity, fair stain, free oil
Lime	4102	4131	
Lime, tan to cream, medium crystalline, collitic, fossiliferous and vuggy	4131	4139	Fair porosity, fair stain, good show of free oil
Lime	4139	4150	<p>DRILL STEM TEST NO. 1</p> <p>4122'-4150', open 1 hour, weak blow, dead in 6 mins., recovered 2' of heavy black oil, 60° oil cut mud, IHP-1255' in 30 mins., IFF-20', FFP-55', FHP-1235' in 30 minutes.</p>
Lime	4150	4183	
Lime, cream, medium crystalline and vuggy	4183	4191	Fair porosity, fair spotted stain, show free oil.
Lime	4191	4200	<p>DRILL STEM TEST NO. 2</p> <p>4180'-4200', open 1 hour, fair blow throughout, no recovery, tool did not close, lost circulation while pulling tester, IHP-1165', IFF-420', FFP-350', FHP-560'. Regained circulation.</p>
Lime	4200	4205	<p>DRILL STEM TEST NO. 3</p> <p>4185'-4205', open 1 hour, weak blow dead in 21 mins., recovered 10' free oil, 150' oil and gas cut mud, IHP-1135' 30 mins., IFF-45', FFP-90', FHP-795' in 30 mins.</p>
Lime and shale	4205	4390	<p>BASE KANSAS CITY 4342'</p> <p>TOP HERRIN 4370'</p>

**TOTAL DEPTH 4390'**  
**Total Depth Reached: 10/13/59**  
 Set and cemented 5 1/2" OD, 14 1/2, SR chd., 3-2, J-55, S.S. casing (1 cond.) at 4389' with 250 sacks of S.O.W. cement, used 130 barrels of oil gelled with 130 sacks of Howco Gel ahead of cement, oil circulated. Finished cementing at 5:00 pm 10/15/59. Ran Halliburton Temperature Survey and found top of cement behind 5 1/2" casing at 2790'.

Rigged up cable tools on October 21, and snubbed the hole down to top of float collar at 4354'.

**Casing Perforation No. 1 - Lansing Line - 4311'-4320'**  
 3/4" type "F" holes

No shows. Treated through 5 1/2" casing with 250 gallons of Halliburton 15% acid as follows:


AUG 29 1960

RECEIVED

TREATMENT NO. 1 - Acidized - 4211'-4220'

Treatment put in 10/22/59 by Halliburton, using 250 gal. loss of acid and 106 barrels of water.

TIME	GP	IP	REMARKS
12:30 am	200		Acid on formation
1:00 am	200		
2:35 am	300		Treatment completed

Swabbed through 5 1/2" casing 3 hours, 95 barrels of water used in treating. On October 22, swabbed through 5 1/2" casing 30 minutes, 11 barrels of water used in treating. Swabbed 5 1/2 hours, 37 barrels of oil (30.4° gravity), 137 barrels of water, swabbing to bottom.

Set Lane-Wells bridging plug at 4280' and swabbed and bailed the hole dry.

Casing Perforation No. 2 - Lansing Line - 4267'-4272'

4267'-4272' 20 type "B" holes

(Left bottom 2' of 4" Lane-Wells perforating gun in hole) 1000' fluid in hole in 1 hour. Swabbed through 5 1/2" casing 4 hours, 13 barrels of oil and 60 barrels of water, swabbing to bottom (20 barrels of fluid per hour, 17% oil). Fished out part of perforating gun, unable to get balance of gun.

Set Lane-Wells bridging plug at 4210'. Swabbed and bailed the hole dry.

Casing Perforation No. 3 - Lansing Line - 4185'-4191'

4185'-4191' 24 type "B" holes

Tested dry. Treated through 5 1/2" casing with 250 gallons of Halliburton 15% acid as follows:

TREATMENT NO. 2 - Acidized - 4181'-4191'

Treatment put in 10/25/59 by Halliburton, using 250 gallons of acid and 103 barrels of oil.

TIME	GP	IP	REMARKS
2:00 am	150		Acid on formation
2:30 am	250		
3:00 am	350		
3:30 am	450		
4:10 am	450		Treatment completed

Swabbed through 5 1/2" casing 3 hours, 103 barrels of water used in treating. Bailed 3 hours, 24 gallons of oil and 20 gallons of acid water per hour. Reacidized through 5 1/2" casing with 750 gallons of Halliburton 15% acid as follows:

TREATMENT NO. 3 - Acidized - 4181'-4191'

Treatment put in 10/25/59 by Halliburton, using 104 barrels of oil and 750 gallons of acid.

TIME	GP	IP	REMARKS
2:15 pm	150		Acid on formation
2:30 pm	400		
2:40 pm	500		
2:55 pm	600		
3:10 pm	650		Treatment completed

Swabbed 1 hour through 5 1/2" casing, 104 barrels of oil used in treating. Then swabbed 6 hours, 6 barrels of oil and 6 barrels of water. Bailed 3 hours, 1 barrel of oil per hour, 1/2 barrel of water.

Set Lane-Wells bridging plug at 4150'. Swabbed and bailed the hole dry.

Casing Perforation No. 4 - Lansing Line - 4132'-4140'

4132'-4140' type "B" holes

No. shows. Treated through 5 1/2" casing with 250 gallons of Halliburton 15% acid as follows:

TREATMENT NO. 4 - Acidized - 4132'-4140'

Treatment put in 10/26/59 by Halliburton, using 250 gallons of acid and 101 barrels of oil.

TIME	GP	IP	REMARKS
2:30 pm	150		Acid on formation
3:00 pm	200		
3:30 pm	300		
4:00 pm	500		
4:25 pm	450		Treatment completed

Swabbed through 5 1/2" casing 1 hour, 101 barrels of oil used in treating. Then swabbed 13 hours, 33 barrels of oil and 145 barrels of water.

Ran 2" tubing and set BM retainer at 4100'. Cemented off perforations from 4132' to 4140' with 150 sacks of S.O.S. cement, 140 sacks below retainer at 3200'-T. Reversed out 10 sacks of cement. Finished at 5:00 am 10/27/59 and pulled 2" tubing and shut down for cement to set.

On October 30, swabbed and bailed the hole dry to top of BM retainer at 4110' and hole tested dry. Drilled retainer and cement plug to 4135'.

Casing Perforation No. 5 - Lansing Line - 4132'-4134'  
4132'-4134' 8 type "B" holes

Tested dry. Treated with 200 gallons of Halliburton 15% acid as follows:

TREATMENT NO. 5 - Acidized - 4132'-4134'

Treatment put in 10/30/59 by Halliburton, using 200 gallons of acid and 101 barrels of water.

TIME	GF	TF	REMARKS
5:15 am	0'		Start acid
5:35 am	0'		Acid on formation
6:30 am	100'		
8:35 am	250'		
9:50 am	300'		
10:05 am	300'		Treatment completed

Swabbed through 5 1/2" casing 1 1/2 hours, 101 barrels of water used in treating. Then swabbed 4 hours, 1 barrel of oil and 27 barrels of water.

Ran 2" tubing and set BM retainer at 4110'. Cemented off perforations from 4132' to 4134' with 150 sacks of common cement, estimated 130 sacks below retainer at 3000'-T. Reversed out estimated 20 sacks. Finished 5:00 am 11/1/59. Pulled tubing and shut down for cement to set. On November 1, swabbed and bailed the hole dry to top of BM retainer at 4110'.

Casing Perforation No. 6 - Lansing Line - 4088'-4094'  
4088'-4094' 24 type "B" holes

Tested dry. Treated through 5 1/2" casing with 250 gallons of Halliburton 15% acid as follows:

TREATMENT NO. 6 - Acidized - 4088'-4094'

Treatment put in 11/1/59 by Halliburton, using 250 gallons of acid and 101 barrels of water.

TIME	GF	TF	REMARKS
4:15 am	0'		Acid on formation
5:45 am	300'		
6:15 am	500'		
6:20 am	400'		
6:53 am	300'		Treatment completed

Swabbed through 5 1/2" casing 2 hours, 101 barrels of water used in treating. Then swabbed 10 hours, 13 barrels of water with some of oil.

On November 2, ran 2" tubing and set BM retainer at 4058'. Cemented off perforations from 4088' to 4094' with 150 sacks of Pozmix cement, estimated 142 sacks below retainer at 2000'. Reversed out 8 sacks, finished 4:00 pm 11/2/59. Pulled 2" tubing and shut down for cement to set. On November 5, drilled BM retainer and cement plug to 4087'.

Casing Perforation No. 7 - Lansing Line - 4078'-4085'  
4078'-4085' 28 type "B" holes

No shows. Treated through 5 1/2" casing with 250 gallons of Halliburton 15% acid as follows:

TREATMENT NO. 7 - Acidized - 4078'-4085'

Treatment put in 11/5/59 by Halliburton, using 250 gallons of acid and 102 barrels of water.

TIME	GF	TF	REMARKS
10:20 pm	100'		Acid on formation
11:30 pm	200'		
12:30 am	500'		
2:30 am	300'		
3:00 am	700'		
3:10 am	600'		
3:20 am	500'		Treatment completed

Swabbed through 5 1/2" casing 3 hours, 102 barrels of water used in treating. Then swabbed through 5 1/2" casing 7 hours, 1 1/4 barrel of oil and 14 barrels of water.

CONSERVATION DIVISION  
MICHIGAN, KANSAS

APR 2 1960

NO. 1000

D

Ran 2" tubing and set DN retainer at 4048'. Cemented off perforations from 4076' to 4085' with 150 sacks of S.O.W. cement, 147 sacks below retainer at 2000'-17'. Reversed out 3 sacks, finished at 12:00 noon 11/7/59. Pulled tubing and shut down for cement to set.

On November 9, swabbed and bailed the hole dry to top of retainer at 4048', drilled retainer and cement plug to 4110'. Drilled retainer at 4110' and cement from 4110' to 4150'. Drove bridging plug from 4150' to 4210'. Drilled and drove bridging plugs from 4210' to 4276' and bailed the hole clean.

Casing Perforation No. 8 - Lansing Lime - 4234'-4238'  
4234'-4238' 16 type "B" holes

Ran 2" tubing and set Halliburton straddle packers with bottom packer set at 4215' and top packer at 4212'. Swabbed through 2" tubing 2 hours, no shows. Treated through 2" tubing with 250 gallons of Halliburton 15% acid as follows:

TREATMENT NO. 8 - Acidized - 4234'-4238'

Treatment put in 11/12/59 by Halliburton, using 250 gallons of acid and 17 barrels of water.

TIME	OP	IP	REMARKS
11:17 pm			Start acid
12:24 pm			Acid on formation
2:55 pm		300%	
3:25 pm		400%	
3:27 pm		Vac.	
3:36 pm		Vac.	Treatment completed

Swabbed through 2" tubing 1 hour, 17 barrels of water used in treating; then swabbed 3 hours, 38 barrels of water, no oil.

Pulled 2" tubing and packers and set Lane-Wells bridging plug at 4215'.

PLUGGED BACK TOTAL DEPTH 4215'

Swabbed through 5 1/2" casing 9 hours, 6 1/2 barrels of oil and 12 1/2 barrels of water. Ran 2" tubing and rods and FOB 5 hours, 7 1/2 barrels of oil and 4.60 barrels of water.

On November 16, FOB 24 hours on State Corporation Commission physical potential test, 27.64 barrels of oil (36° gravity) and 21.46 barrels of water, to establish 24 hour S.C.G. potential of 26 barrels. Daily allowable 28 barrels.

SLOPE TEST DATA

DEPTH	ANGLE OF DEFLECTION
500'	1/4 degree
1000'	1/4 "
1500'	1/2 "
2000'	1/4 "
2500'	1/4 "
3000'	1/2 "
3500'	1/2 "
4000'	1/2 "