

STATE OF KANSAS
STATE CORPORATION COMMISSION

15-153-20007-00-00


Form CP-4

WELL PLUGGING RECORD

Give All Information Completely
Make Required Affidavit
Mail or Deliver Report to:
Conservation Division
State Corporation Commission
212 No. Market
Wichita, Kansas

Rawlins County, Sec. 26 Twp. 1S Rge. 35 ~~XXXXX~~(W)

Location as "NE/CNW/SW" or footage from lines. NW SE SE SE
Lease Owner Aladdin Petroleum Corporation
Lease Name Bettie Skolout Well No. 1
Office Address 809 Petroleum Building
Character of Well (completed as Oil, Gas or Dry Hole) Dry Hole
Date well completed March 14 1967
Application for plugging filed March 14 1967
Application for plugging approved March 14 1967
Plugging commenced March 14 1967
Plugging completed March 14 1967
Reason for abandonment of well or producing formation Dry Hole

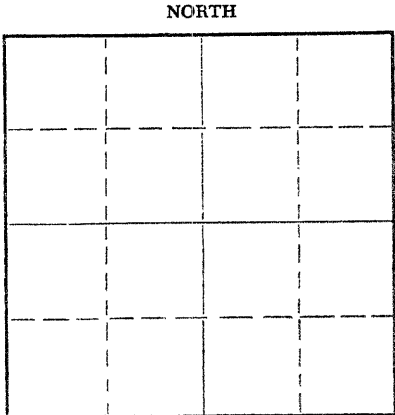

Locate well correctly on above Section Plat

If a producing well is abandoned, date of last production 19
Was permission obtained from the Conservation Division or its agents before plugging was commenced? yes

Name of Conservation Agent who supervised plugging of this well W. L. Nichols, Morland, Kansas 67650
Producing formation _____ Depth to top _____ Bottom _____ Total Depth of Well 4401 Feet
Show depth and thickness of all water, oil and gas formations.

OIL, GAS OR WATER RECORDS

CASING RECORD

FORMATION	CONTENT	FROM	TO	SIZE	PUT IN	PULLED OUT
Surface	- Shale	0	277	8 5/8"	253'	-0-

Describe in detail the manner in which the well was plugged, indicating where the mud fluid was placed and the method or methods used in introducing it into the hole. If cement or other plugs were used, state the character of same and depth placed, from _____ feet to _____ feet for each plug set.

Plug set at 660' with 20 sacks cement.
Plug set at 270' with 20 sacks cement.
Plug set at 40' with 10 sacks cement.

RECEIVED
STATE CORPORATION COMMISSION
MAY 12 1967
5-12-67
CONSERVATION DIVISION
Wichita, Kansas

(If additional description is necessary, use BACK of this sheet)

Name of Plugging Contractor Empire Drilling Company
Address 650 4th Natl. Bank Bldg., Wichita, Kansas 67202

STATE OF Kansas, COUNTY OF Sedgwick, ss. contractor
Dan J. Kornfeld (employee of owner, contractor or operator) of the above-described well, being first duly sworn on oath, says: That I have knowledge of the facts, statements, and matters herein contained and the log of the above-described well as filed and that the same are true and correct. So help me God.

(Signature) Dan J. Kornfeld
650 4th Natl. Bank Bldg., Wichita, Kansas 67202
(Address)

SUBSCRIBED AND SWORN TO before me this 17th day of March, 1967

Sandra Kay Peer
Sandra Kay Peer Notary Public.

My commission expires September 14, 1968.

LOG

COMPANY: Aladdin Petroleum Corporation
 CONTRACTOR: Empire Drilling Company 15-153-20007-00-00
 FARM: Bettie Skolout #1
 LOCATION: NW SE SE SE Section 26-1S-35W, Rawlins County, Kansas
 COMMENCED: March 4, 1967 ELEVATION: 3197 KB
 COMPLETED: March 14, 1967 POTENTIAL: D & A

0	to	277	Surface-Shale
277	to	1130	Shale & Bentonite
1130	to	1860	Shale
1860	to	2400	Shale & Sand
2400	to	2610	Shale - Gypsum - Sand
2610	to	2866	Shale & Gypsum
2866	to	2880	Blaine Gypsum
2880	to	3051	Redbed
3051	to	3087	Anhydrite
3087	to	3145	Shale & Shells
3145	to	3320	Shale & Lime
3320	to	4401	Lime
4401			Rotary Total Depth

SET: 253' of 8 5/8" with 125 sacks cement.

ELECTRIC LOG TOPS:

Anhydrite	3050	+147
Topeka	3984	-787
Heebner	4070	-873
Leavenworth	4072	-875
Oread	4082	-885
Lansing Kansas City	4122	-925
Base Kansas City	4394	-1197
Total Depth	4401	-1204

RECEIVED
 STATE CORPORATION COMMISSION
 APR 5 1967
 4-5-67
 CONSERVATION DIVISION
 Wichita, Kansas

C E R T I F I C A T I O N

I, Dan J. Kornfeld, do hereby certify that the above and foregoing is a true and correct copy of the log on the Bettie Skolout #1 NW SE SE SE Section 26-1S-35W, Rawlins County, Kansas, as reflected by the files of Empire Drilling Company.

Dan J. Kornfeld
 Dan J. Kornfeld

Subscribed and sworn to before me, a Notary Public, within and for Sedgwick County, Kansas, this 31st day of March, 1967.

Sandra Kay Pear
 Sandra Kay Pear, Notary Public

My commission expires September 14, 1968.