

API NUMBER 15-153-20,792-00-00

LEASE NAME Majour

WELL NUMBER 1

1,650 Ft. from S Section Line

2,970 Ft. from E Section Line

SEC. 22 TWP. 1 RGE. 35 (X) or (W)

COUNTY Rawlins

Date Well Completed 10-28-92

Plugging Commenced 10-28-92

Plugging Completed 10-29-92

TYPE OR PRINT
 NOTICE: Fill out completely
 and return to Cons. Div.
 office within 30 days.

LEASE OPERATOR Russell Oil, Inc.

ADDRESS PO Box 272, Russell, KS. 67665

PHONE#(913) 483-3954 OPERATORS LICENSE NO. 3,293

Character of Well D & A

(Oil, Gas, D&A, SWD, Input, Water Supply Well)

The plugging proposal was approved on 10-28-92 (date)

by Ed Schumacher (KCC District Agent's Name).

Is ACO-1 filed? No If not, is well log attached? Yes

Producing Formation _____ Depth to Top _____ Bottom _____ T.D. 4,405'

Show depth and thickness of all water, oil and gas formations.

OIL, GAS OR WATER RECORDS

CASING RECORD

Formation	Content	From	To	Size	Put in	Pulled out
				8 5/8"	304'	Cmtd. w/170 sax

Describe in detail the manner in which the well was plugged, indicating where the mud fluid was placed and the method or methods used in introducing it into the hole. If cement or other plugs were used, state the character of same and depth placed, from feet to feet each set.
Fill hole w/heavy mud. Push bridge plug to 3,090', spot 25 sax cement on plug thru drill pipe. Push bridge plug to 2,335', spot 100 sax cement on plug thru drill pipe. Push bridge plug to 355', spot 40 sax cement on plug thru drill pipe. Push wiper plug to 40', dump 10 sax cement on plug. Dump 15 sax cement down rat hole and 10 sax cement down mouse hole.
 (If additional description is necessary, use BACK of this form.)

Name of Plugging Contractor Shields Drilling Co. License No. 160

Address Shields Bldg., Russell, KS. 67665

NAME OF PARTY RESPONSIBLE FOR PLUGGING FEES: Russell Oil, Inc.

STATE OF KANSAS COUNTY OF RUSSELL, ss.

Jack P. Beeman, Sec.-Treas. (Employee of Operator) or Operator of above-described well, being first duly sworn on oath, says: That I have knowledge of the facts, statements, and matters herein contained and the log of the above-described well as filed that the same are true and correct, so help me God.

(Signature) Jack P. Beeman, Sec.-Treas.


(Address) Shields Bldg., Russell, KS. 67665

SUBSCRIBED AND SWORN TO before me this 9th day of November, 19 92

Ruth Phillips

Notary Public

My Commission Expires:

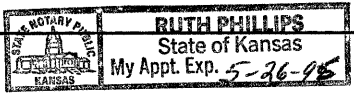



Shields


Russell, Kansas

WELL LOG

Operator: Russell Oil, Inc.
 Well: Majour #1
 Commenced: October 21, 1992
 Completed: October 28, 1992
 Contractor: Shields Drilling Co.

Well Description:

^{NE} SE ~~NW~~ SW
 Sec. 22-1S-35W
 Rawlins Co., KS.

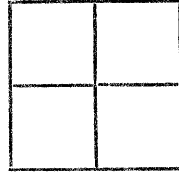

Elevation: 3,188' KB

Treatment:

Production: D & A

Tops:

CASING RECORD

Size	Run	Pulled
8 5/8"	304'	Cmtd. w/170 sax

..... Figures Indicate Bottom of Formations

Sand & shale	1,882'	
Shale	2,737'	
Shale & sand	3,034'	
Shale	3,060'	
Anhydrite	3,096'	
Shale	3,960'	
Shale & lime	4,188'	
Lime	4,405'	RTD

ORIGINAL

Notes