

STATE OF KANSAS  
STATE CORPORATION COMMISSION


Give All Information Completely  
Make Required Affidavit  
Mail or Deliver Report to:  
Conservation Division  
State Corporation Commission  
212 North Market, Insurance Bldg.  
Wichita, Kansas

15-153-30101-00-00  
WELL PLUGGING RECORD

Rawlins County, Sec. 21 Twp. 1S Rge. (E) 35(W)

Location as "NE/CNW/SW" or footage from lines NE-NE  
Lease Owner Amerada Petroleum Corporation  
Lease Name Anna Christenson Well No. 1  
Office Address Box 197, Great Bend, Kansas  
Character of Well (completed as Oil, Gas or Dry Hole) Dry Hole  
Date well completed 9-30-1960  
Application for plugging filed 9-30-1960  
Application for plugging approved 9-30-1960  
Plugging commenced 9-30-1960  
Plugging completed 9-30-1960  
Reason for abandonment of well or producing formation Dry Hole

NORTH

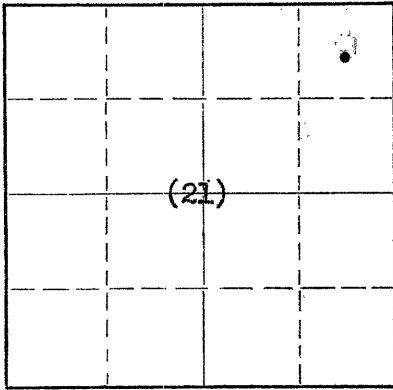

Locate well correctly on above Section Plat

If a producing well is abandoned, date of last production — 19—

Was permission obtained from the Conservation Division or its agents before plugging was commenced? Yes

Name of Conservation Agent who supervised plugging of this well A. D. Fabricius

Producing formation — Depth to top — Bottom — Total Depth of Well 4880 Feet

Show depth and thickness of all water, oil and gas formations.

OIL, GAS OR WATER RECORDS

CASING RECORD

FORMATION	CONTENT	FROM	TO	SIZE	PUT IN	PULLED OUT
				8-5/8"	350'	None

Describe in detail the manner in which the well was plugged, indicating where the mud fluid was placed and the method or methods used in introducing it into the hole. If cement or other plugs were used, state the character of same and depth placed, from — feet to — feet for each plug set.

Globe Cementing spotted cement plugs as follows:

- Spotted cement plug @ 600' w/20 sax cement.
- Filled hole w/heavy mdu 600' to 345'.
- Spotted cement plug @ 345' w/20 sax cement.
- Filled hole w/heavy mud 345' to 40'.
- Spotted cement plug 40' to Top W/10 Sax Cement.

RECEIVED  
OCT 5 1960  
STATE CORPORATION COMMISSION  
CONSERVATION DIVISION  
WICHITA, KANSAS  
10-5-1960

(If additional description is necessary, use BACK of this sheet)

Name of Plugging Contractor Jelly Reaves Drilling Co.  
Address Box 1264, Cushing, Oklahoma

STATE OF Kansas, COUNTY OF Barton, ss.  
Ernest Higgins (employee of owner) or (owner or operator) of the above-described well, being first duly sworn on oath, says: That I have knowledge of the facts, statements, and matters herein contained and the log of the above-described well as filed and that the same are true and correct. So help me God.

(Signature) Ernest Higgins  
Box 197, Great Bend, Kansas  
(Address)

SUBSCRIBED AND SWORN TO before me this 3rd day of October, 1960

My commission expires November 21, 1961

Chala W. Adams  
Notary Public.



Jelly Reaves Drilling Co.  
P. O. Box 1264  
Cushing, Oklahoma

15-153-30101-00-00

Anna Christensen #1  
Sec. 21, 18, 35W  
Rawlins County, Kansas

*R*  
DRILLING LOG

- 0 - 1305 Shale & sand
- 1305 - 2140 Shale
- 2140 - 2345 Sand
- 2345 - 2490 Sandy shale
- 2490 - 2640 Shale
- 2640 - 2700 Shale & shells
- 2700 - 2750 Sand
- 2750 - 2950 Shale
- 2950 - 3010 Red Bed
- 3010 - 3125 Shale & anhydrite
- 3125 - 3264 limy shale
- 3264 - 3600 Shale
- 3600 - 3660 Lime
- 3660 - 3745 Shale
- 3745 - 3765 Lime
- 3765 - 3830 Shale & lime
- 3830 - 4009 Lime
- 4009 - 4012 Sand
- 4012 - 4043 Shale
- 4043 - 4047 Sand
- 4047 - 4089 Lime
- 4089 - 4138 Liza & sand
- 4138 - 4665 Lime
- 4665 - 4795 Sand
- 4795 - 4880 Lime

C  
O  
P  
Y

RECEIVED  
STATE CORPORATION COMMISSION  
OCT 17 1960  
CONSELY  
10-17-60