

Give All Information Completely
Make Required Affidavit
Mail or Deliver Report to:
Conservation Division
State Corporation Commission
211 No. Broadway
Wichita, Kansas

WELL PLUGGING RECORD

15-153-30098-00-00

Rawlins County, Sec. 13 Twp. 1S Rge. (E) 35(W)

Location as "NE/CNW/SW" or footage from lines NE SW

Lease Owner Lincoln Maggard

Lease Name SIS Well No. 1

Office Address 301 1/2 Norris Avenue - McCook, Nebraska

Character of Well (completed as Oil, Gas or Dry Hole) Dry Hole

Date well completed 12-13-64 19

Application for plugging filed 12-13-64 19

Application for plugging approved 12-13-64 19


Plugging commenced 12-13-64 19

Plugging completed 12-13-64 19

Reason for abandonment of well or producing formation Dry Hole

If a producing well is abandoned, date of last production 19

Was permission obtained from the Conservation Division or its agents before plugging was commenced? yes

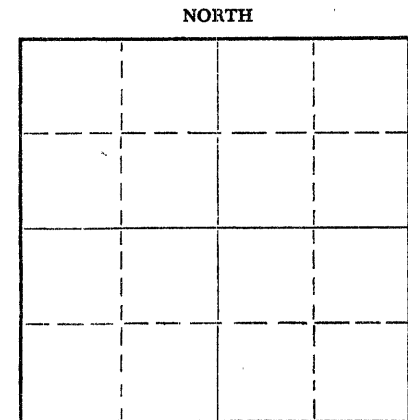

Name of Conservation Agent who supervised plugging of this well W. L. Nichols - Moreland, Kansas

Producing formation Depth to top Bottom Total Depth of Well 4310 Feet

Show depth and thickness of all water, oil and gas formations.

OIL, GAS OR WATER RECORDS

CASING RECORD

FORMATION	CONTENT	FROM	TO	SIZE	PUT IN	PULLED OUT

Describe in detail the manner in which the well was plugged, indicating where the mud fluid was placed and the method or methods used in introducing it into the hole. If cement or other plugs were used, state the character of same and depth placed, from feet to feet for each plug set.

1st plug @ 660' w/20 sacks cement
2nd plug @ 240' w/20 sacks cement
3rd plug @ 40' w/10 sacks cement

RECEIVED
STATE CORPORATION COMMISSION
12-29-1964
DEC 29 1964

CONSERVATION DIVISION
Wichita, Kansas

(If additional description is necessary, use BACK of this sheet)

Name of Plugging Contractor Murfin Drilling Company

Address 617 Union Center - Wichita, Kansas

STATE OF Kansas, COUNTY OF Sedgwick, ss.

C. Robert Buford (employee of owner) or (owner or operator) of the above-described well, being first duly sworn on oath, says: That I have knowledge of the facts, statements, and matters herein contained and the log of the above-described well as filed and that the same are true and correct. So help me God.

(Signature) MURFIN DRILLING COMPANY

By: C. Robert Buford

(Address) C. Robert Buford

SUBSCRIBED AND SWORN TO before me this 23rd day of December, 1964

SANDRA S. HOLZMAN, Notary Public
My commission expires March 4, 1968

Sandra S. Holzman

Notary Public.

WELL LOG

15-153-30098-00-00

COMPANY Lincoln Maggard

SEC. 13 T. 1-S R. 35-W
LOC. NE SW

FARM SIS NO. 1

RIG. NO. 16

TOTAL DEPTH 4310'


COUNTRY Rawlins - Ks.
KANSAS

COMM. 12-5-64 COMP. 12-13-64

SHOT OR TREATED

CONTRACTOR Murfin Drilling Company

ISSUED

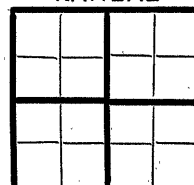

CASING

20 10
15 8 5/8" 258' w/250 sacks
12 6
13 5

ELEVATION 3103 DF

PRODUCTION D&A

FIGURES INDICATE BOTTOM OF FORMATIONS

100 Shale
220 Sand
260 Blue Shale
1345 Shale
2065 Shale & Sand
2295 Sand & Shale
2500 Shale & Sand
2680 Shale
2715 Anhydrite
2793 Shale
2807 Gypsum
2984 Red Bed
3018 Anhydrite
3090 Shale
3365 Shale & Lime
4150 Lime & Shale
4205 Lime
4310 Lime & Shale
4310 RTD

RECEIVED
STATE CORPORATION COMMISSION
DEC 29 1964
12-29-1964
CONSERVATION DIVISION
Wichita, Kansas

State of KANSAS
County of SEDGWICK ss:

I, C. Robert Buford of the Murfin Drilling Company Company

upon oath state that the above and foregoing is a true and correct copy of the log of the SIS #1 well.

MURFIN DRILLING COMPANY

By: C. Robert Buford
C. Robert Buford

Subscribed and sworn to before me this 23rd day of December 19 64

SANDRA S. HOLZMAN, Notary Public
My Commission Expires My commission expires March 4, 1968

Sandra S. Holzman

NOTARY PUBLIC