

CARD MUST BE TYPED

State of Kansas
NOTICE OF INTENTION TO DRILL
(see rules on reverse side)

CARD MUST BE SIGNED

Starting Date: October 1985
month day year

API Number 15- 153-20,635-00-00

OPERATOR: License # 6499
Name Abraxas Petroleum Corporation
Address P.O. Box 17485
City/State/Zip San Antonio, Texas 78217
Contact Person Harris T. Papahronis
Phone 512-828-5354

SE .. NE .. Sec 23 .. Twp .. 1 .. S, Rge 35 ..
(location) East West

..... 3300 Ft North from Southeast Corner of Section
..... 660 Ft West from Southeast Corner of Section
(Note: Locate well on Section Plat on reverse side)

CONTRACTOR: License # not assigned yet
Name
City/State

Nearest lease or unit boundary line feet.
County Rawlins
Lease Name Rooney Well# 3

Domestic well within 330 feet : yes no
Municipal well within one mile : yes no

Well Drilled For: Well Class: Type Equipment:
 Oil Swd Infield Mud Rotary
 Gas Inj Pool Ext. Air Rotary
 OWWO Expl Wildcat Cable

Depth to Bottom of fresh water ³⁰⁰⁻²²⁰ feet
Lowest usable water formation ^{Dakota} Ojallalla
Depth to Bottom of usable water ²¹⁵⁰ 250 feet
Surface pipe by Alternate : 1 2

If OWWO: old well info as follows:
Operator
Well Name
Comp Date Old Total Depth
Projected Total Depth 4400 feet
Projected Formation at TD Lansing
Expected Producing Formations Lansing

Surface pipe to be set 320 feet
Conductor pipe if any required None feet
Ground surface elevation feet MSL
This Authorization Expires ³⁻¹⁶⁻⁸⁶
Approved By ⁹⁻¹⁶⁻⁸⁵ R. P. ...

I certify that we will comply with K.S.A. 55-101, et seq., plus eventually plugging hole to K.C.C. specifications.

Date 9-10-85 Signature of Operator or Agent


Marian Bailey

Production Secretary

**Must be filed with the K.C.C. five (5) days prior to commencing well
This card void if drilling not started within six (6) months of date received by K.C.C.**

Important procedures to follow :

**A Regular Section of Land
1 Mile = 5,280 Ft.**

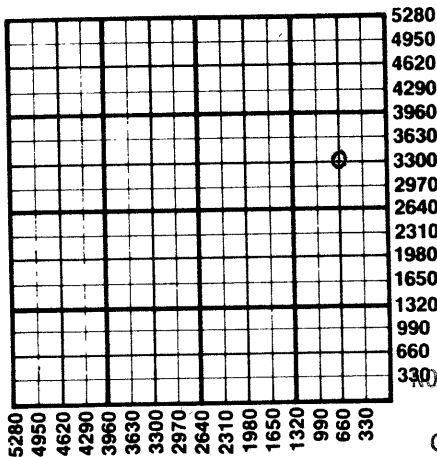

1. Notify District office before setting surface casing.
2. Set surface casing by circulating cement to the top.
3. File completion forms ACO-1 with K.C.C. within 90 days of well completion, following instructions on ACO-1, side 1, and including copies of wireline logs.
4. Notify District office 48 hours prior to old well workover or re-entry.
5. Prior to plugging, prepare a plugging plan, then obtain agreement from the appropriate district office for an approved plugging plan.
6. Submit plugging report (CP-4) to K.C.C. after plugging is completed.
7. Obtain an approved injection docket number before disposing of salt water.
8. Notify K.C.C. within 10 days when injection commences or terminates.

an alternate 2 completion, cement in the production pipe from below
any usable water to surface within 120 days of spud date.

RECEIVED
 STATE CORPORATION COMMISSION
 9-16-85
 SEP 16 1985

State Corporation Commission of Kansas
Conservation Division
200 Colorado Derby Building
Wichita, Kansas 67202
(316)263-3238