

CARD MUST BE TYPED

State of Kansas  
**NOTICE OF INTENTION TO DRILL**

CARD MUST BE SIGNED

(see rules on reverse side)

Starting Date: ..... 8 ..... 1 ..... 85 .....  
month day year

API Number 15- 153-20,620-00-00

OPERATOR: License # ..... 5422 .....

.. C. NE NE SE. Sec 23. Twp 1S. S, Rge 35W.  East  
(location)  West

Name .. Abercrombie Drilling, Inc. ....

Address 801 Union Center .....

City/State/Zip Wichita, KS 67202 .....

Contact Person Jack L. Partridge .....

Phone 262-1841 .....

..... 2310' ..... Ft North from Southeast Corner of Section  
..... 330' ..... Ft West from Southeast Corner of Section  
(Note: Locate well on Section Plat on reverse side)

CONTRACTOR: License # ..... 5422 .....

Name .. Abercrombie Drilling, Inc. ....

City/State .. Wichita, KS 67202 .....

Nearest lease or unit boundary line ..... 330 ..... feet.  
County ..... Rawlins .....

Lease Name .. Skolout ..... Well# ..... 1 .....

Domestic well within 330 feet :  yes  no

Municipal well within one mile :  yes  no

**Well Drilled For:**

**Well Class:**

**Type Equipment:**

- Oil  Swd  Infield
- Gas  Inj  Pool Ext.
- OWWO  Expl  Wildcat

- Mud Rotary
- Air Rotary
- Cable

If OWWO: old well info as follows:

Operator .....

Well Name .....

Comp Date ..... Old Total Depth .....

Projected Total Depth ..... 4400 ..... feet

Projected Formation at TD ..... Conglomerate .....

Expected Producing Formations ..... Lansing/Kansas City .....

Depth to Bottom of fresh water ..... 200 ..... feet

Lowest usable water formation ..... Dakota Gallowah .....

Depth to Bottom of usable water ..... 250 ..... feet

Surface pipe by Alternate : 1  2

Surface pipe to be set ..... 300 ..... feet

Conductor pipe if any required ..... None ..... feet

Ground surface elevation ..... 3170 estimated ..... feet MSL

This Authorization Expires 1-22-86

Approved By P.C.H. 7-22-85

I certify that we will comply with K.S.A. 55-101, et seq., plus eventually plugging hole to K.C.C. specifications.

Date 7-22-85 ..... Signature of Operator or Agent

*Jack L. Partridge*

Jack L. Partridge

Title Vice-President .....


Must be filed with the K.C.C. five (5) days prior to commencing well  
 This card void if drilling not started within six (6) months of date received by K.C.C.

RECEIVED  
 STATE CORPORATION COMMISSION  
 7-22-85  
 JUL 22 1985

**Important procedures to follow :**

**A Regular Section of Land**  
 1 Mile = 5,280 Feet  
 CONSERVATION DIVISION  
 WICHITA, KANSAS

1. Notify District office before setting surface casing.
2. Set surface casing by circulating cement to the top.
3. File completion forms ACO-1 with K.C.C. within 90 days of well completion, following instructions on ACO-1, side 1, and including copies of wireline logs.
4. Notify District office 48 hours prior to old well workover or re-entry.
5. Prior to plugging, prepare a plugging plan, then obtain agreement from the appropriate district office for an approved plugging plan.
6. Submit plugging report (CP-4) to K.C.C. after plugging is completed.
7. Obtain an approved injection docket number before disposing of salt water.
8. Notify K.C.C. within 10 days when injection commences or terminates.
9. If an alternate 2 completion, cement in the production pipe from below any usable water to surface within 120 days of spud date.

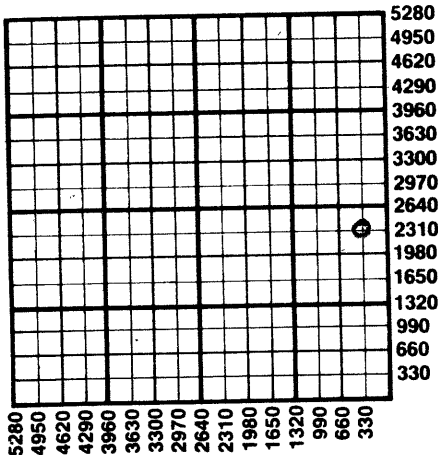

**State Corporation Commission of Kansas**  
**Conservation Division**  
**200 Colorado Derby Building**  
**Wichita, Kansas 67202**  
**(316) 263-3238**