

15-153-20090-00-00


STATE OF KANSAS  
STATE CORPORATION COMMISSION

Form CP-4

Give All Information Completely  
Make Required Affidavit  
Mail or Deliver Report to:  
Conservation Division  
State Corporation Commission  
212 No. Market  
Wichita, Kansas 67202

WELL PLUGGING RECORD

NORTH

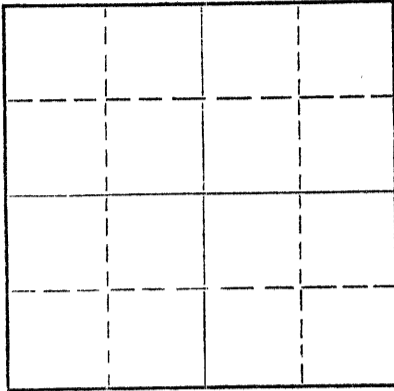

Locate well correctly on above  
Section Plat

Rawlins County. Sec. 31 Twp. 1S Rge. (E)B5 (W)  
Location as "NE/CNW/SW" or footage from lines C NE NW  
Lease Owner Husky Oil Company of Delaware  
Lease Name Reeh Well No. 3-31  
Office Address P. O. Box 380 - Cody, Wyoming 82414  
Character of Well (completed as Oil, Gas or Dry Hole) Dry Hole  
Date well completed Nov. 3 19 70  
Application for plugging filed Nov. 6 19 70  
Application for plugging approved Nov. 3 19 70  
Plugging commenced Nov. 3 19 70  
Plugging completed Nov. 3 19 70  
Reason for abandonment of well or producing formation

If a producing well is abandoned, date of last production 19  
Was permission obtained from the Conservation Division or its agents before plugging was commenced? Yes

Name of Conservation Agent who supervised plugging of this well Leo Massey  
Producing formation Depth to top Bottom Total Depth of Well 4530 Feet  
Show depth and thickness of all water, oil and gas formations.

OIL, GAS OR WATER RECORDS

CASING RECORD

FORMATION	CONTENT	FROM	TO	SIZE	PUT IN	PULLED OUT
		0	324'	8-5/8"	324'	None

Describe in detail the manner in which the well was plugged, indicating where the mud fluid was placed and the method or methods used in introducing it into the hole. If cement or other plugs were used, state the character of same and depth placed, from feet to feet for each plug set.

Filled hole with heavy mud to 2350 ft. Set first plug @ 2350 ft. w/70 sacks cement.  
Filled hole with heavy mud to 330 ft. Set second plug @ 330 ft. w/20 sacks cement.  
Filled hole with heavy mud to 40 ft. Set third plug @ 40 ft. w/10 sacks cement.  
Job complete @ 3:00 PM, Nov. 3, 1970

RECEIVED  
STATE CORPORATION COMMISSION  
NOV 9 1970  
CONSERVATION DIVISION  
Wichita, Kansas

11-9-70

(If additional description is necessary, use BACK of this sheet)

Name of Plugging Contractor Gabbert-Jones, Inc.  
Address 830 Sutton Place - Wichita, Kansas 67202

STATE OF Kansas, COUNTY OF Sedgwick, ss.

James S. Sutton, II (employee of owner) or (owner or operator) of the above-described well, being first duly sworn on oath, says: That I have knowledge of the facts, statements, and matters herein contained and the log of the above-described well as filed and that the same are true and correct. So help me God.

(Signature)

830 Sutton Place - Wichita, Kansas 67202  
(Address)

Subscribed and sworn to before me this 5 day of November, 1970

My commission expires

1, 1972

Barbara J. Layton  
Notary Public.

Notary Public.



