


15-153-20195-00-00

FORM CP-4

STATE OF KANSAS
STATE CORPORATION COMMISSION
CONSERVATION DIVISION
P. O. BOX 17027
WICHITA, KANSAS 67217

WELL PLUGGING RECORD

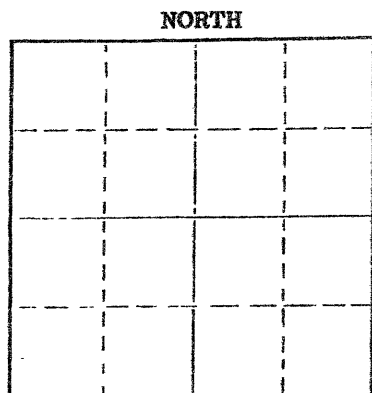

Locate well correctly on above Section Plat

Rawlins County, Sec. 33 Twp. 1 Rge. 32W (E) (W)
Location as "NE/CNWESW" or footage from lines C SW NW
Lease Owner Donald C. Slawson
Lease Name Kompus 'C' Well No. 1
Office Address 408 120 Bldg. Wichita, Ks. 67202
Character of Well (completed as Oil, Gas or Dry Hole) Dry Hole
Date well completed Jan. 18, 1975 19
Application for plugging filed Jan. 18, 1975 19
Application for plugging approved Jan. 18, 1975 19
Plugging commenced Jan. 18, 1975 19
Plugging completed Jan. 18, 1975 19
Reason for abandonment of well or producing formation Dry Hole

If a producing well is abandoned, date of last production 19
Was permission obtained from the Conservation Division or its agents before plugging was commenced? Yes

Name of Conservation Agent who supervised plugging of this well W. L. Nichols Moreland, Ks.
Producing formation Depth to top Bottom Total Depth of Well 2760
Show depth and thickness of all water, oil and gas formations.

OIL, GAS OR WATER RECORDS

CASING RECORD

FORMATION	CONTENT	FROM	TO	SIZE	PUT IN	PULLED OUT
8 5/8"	288 feet				295 feet	

Describe in detail the manner in which the well was plugged, indicating where the mud fluid was placed and the method or methods used in introducing it into the hole. If cement or other plugs were used, state the character of same and depth placed, from feet to feet for each plug set.

1st plug @ 900 feet w/70 sx
2nd plug @ 295 feet w/20 sx
3rd plug @ 40 feet w/10 sx

(If additional description is necessary, use BACK of this sheet)
Name of Plugging Contractor Slawson Drlg. Co., Inc.
Address 408 120 Bldg. Wichita, Ks. 67202

STATE OF Kansas COUNTY OF Sedgwick ss.
James C. Remsberg (employee of owner) or (owner or operator) of the above-described

well, being first duly sworn on oath, says: That I have knowledge of the facts, statements, and matters herein contained and the log of the above-described well as filed and that the same are true and correct. So help me God.

(Signature) James C. Remsberg
(Address)

Subscribed and Sworn to before me this 28th day of January, 1975

My commission expires
DOLORES B. COADY
STATE NOTARY PUBLIC
SEDGWICK COUNTY, KANSAS
Comm. Expires Mar. 7, 1976

(Signature) Dolores B. Coady
(Address) Dolores B. Coady Notary Public

RECEIVED
STATE CORPORATION COMMISSION
1975
02-04-1975
CONSERVATION DIVISION
Wichita, Kansas

WELL LOG

COMPANY: Donald C. Slawson
 408 120 Building
 Wichita, Kansas 67202

LEASE: Kompus 'C' No. 1
 C SW NW of Sec. 33-1-32W
 Rawlins County, Kansas

TOTAL DEPTH: 2760 feet

CONTRACTOR: Slawson Drilling Company, Inc.

COMMENCED: 1-15-75

COMPLETED: 1-18-75

CASING: Set 8 5/8" @ 295 feet w/225 sx

0-301	Surface Hole
301-2660	Shale and Shells
2660-2702	Anhydrite
2702-2760	Shale and Shells
2760	RTD

STATE OF KANSAS)
) SS.
 COUNTY OF SEDGWICK)

I, JAMES C. REMSBERG, of the Slawson Drilling Company, Inc. upon oath state that the above and foregoing is a true and correct copy of the log of the Kompus 'C' No. 1 well.

James C. Remsberg

 JAMES C. REMSBERG

Subscribed and sworn to before me this 28th day of January, 1975.

Dolores B. Coady

 Dolores B. Coady, Notary Public

My Commission Expires:

 DOLORES B. COADY
 STATE NOTARY PUBLIC
 SEDGWICK COUNTY, KANSAS
 Comm. Expires Mar. 7, 1976

RECEIVED
 STATE CORPORATION COMMISSION
 02-04-1975
 1975
 CONSERVATION DIVISION
 Wichita, Kansas