

CARD MUST BE TYPED

State of Kansas

CARD MUST BE SIGNED

Rec'd 2-13-86

NOTICE OF INTENTION TO DRILL

(see rules on reverse side)

Starting Date 3 8 86
month day year

OPERATOR: License # 5011
Name Viking Resources
Address 217 E. William
City/State/Zip Wichita, KS 67202-4005
Contact Person Jim Devlin
Phone 316-262-2502

CONTRACTOR: License # 5420
Name White and Ellis Drilling, Inc.
City/State Wichita, KS

Well Drilled For: Well Class: Type Equipment:
 Oil SWD Infield Mud Rotary
 Gas Inj Pool Ext. Air Rotary
 OWWO Expl Wildcat Cable

If OWWO: old well info as follows:

Operator
Well Name
Comp Date Old Total Depth

I certify that well will comply with K.S.A. 55-101, et seq., plus eventually plugging hole to KCC specifications.

Date 12 February 1986 Signature of Operator or Agent James B. Darlin Title Operator

For KCC Use:

Conductor Pipe Required feet; Minimum Surface Pipe Required 250 feet per Alloy 1

This Authorization Expires 8-13-86 Approved By 2-13-86

API Number 15- 153-20,652-00-00
165' S of _____ East
W 1/2 E 1/2 NE Sec. 35. Twp. 1. S, Rg. 35. West
3795 Ft. from South Line of Section
990 Ft. from East Line of Section
(Note: Locate well on Section Plat on reverse side)

Nearest lease or unit boundary line 990 feet
County Rawlins
Lease Name Prochazka Well # ?
Ground surface elevation 3225 est. feet MSL
Domestic well within 330 feet: _____ yes no
Municipal well within one mile: _____ yes no
Surface pipe by Alternate: 1 2
Depth to bottom of fresh water 200
Depth to bottom of usable water 250
Surface pipe planned to be set 280
Projected Total Depth 4400 feet
Formation Base Kansas City

pet/ok


OK

Must be filed with the K.C.C. five (5) days prior to commencing well
 This card void if drilling not started within six (6) months of date received by K.C.C.

Important procedures to follow:

1. Notify District office before setting surface casing.
2. Set surface casing by circulating cement to the top.
3. File completion forms ACO-1 with K.C.C. within 90 days of well completion, following instructions on ACO-1, side 1, and including copies of wireline logs.
4. Notify District office 48 hours prior to old well workover or re-entry.
5. Prior to filing Intent, prepare a proposed plugging plan in case well is D & A, then obtain approval of plan when calling district office prior to setting surface pipe.
6. Submit plugging report (CP-4) to K.C.C. after plugging is completed.
7. Obtain an approved injection docket number before disposing of salt water.
8. Notify K.C.C. within 10 days when injection commences or terminates.
9. If an alternate 2 completion, cement in the production pipe from $\frac{1}{2}$ below any usable water to surface within 120 days of spud date.

A Regular Section of Land
1 Mile = 5,280 Ft.

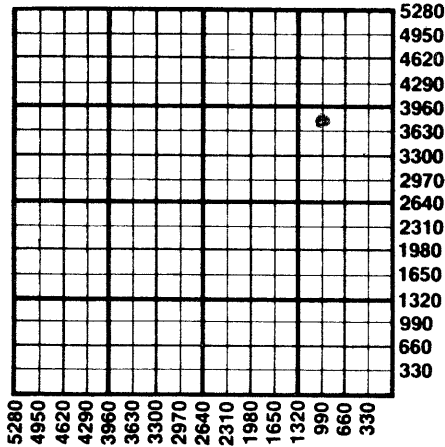

STATE CORPORATION COMMISSION

FEB 15 1986
 2-13-86
 CONSERVATION DIVISION
 Wichita, Kansas

State Corporation Commission of Kansas
 Conservation Division
 200 Colorado Derby Building
 Wichita, Kansas 67202
 (316) 263-3238