

CARD MUST BE TYPED

State of Kansas

CARD MUST BE SIGNED

Rec'D 2-13-86

NOTICE OF INTENTION TO DRILL

(see rules on reverse side)

Starting Date 3 1 86 month day year

API Number 15-153-20,651-00-00 165' N of

OPERATOR: License # 5011

N 1/2 SE SE Sec. 35 Twp. 1 S, Rg. 35 X West

Name Viking Resources

Address 217 E. William

1155 Ft. from South Line of Section

City/State/Zip Wichita, KS 67202-4005

660 Ft. from East Line of Section

Contact Person Jim Devlin

Phone 316-262-2502

(Note: Locate well on Section Plat on reverse side)

CONTRACTOR: License # 5420

Nearest lease or unit boundary line 660 feet

Name White and Ellis Drilling, Inc.

County Rawlins

City/State Wichita, KS 67202

Lease Name Elliott Well # 2

Well Drilled For: Well Class: Type Equipment:

Ground surface elevation 3225 est. feet MSL

X Oil SWD X Infield X Mud Rotary

Domestic well within 330 feet: yes X no

Gas Inj Pool Ext Air Rotary

Municipal well within one mile: yes X no

OWWO Expl Wildcat Cable

Surface pipe by Alternate: 1 X 2

If OWWO: old well info as follows:

Operator

Depth to bottom of fresh water 200

Well Name

Depth to bottom of usable water 250

Comp Date Old Total Depth

Surface pipe planned to be set 280

Projected Total Depth 4400 feet

Formation Base Kansas City

I certify that well will comply with K.S.A. 55-101, et seq., plus eventually plugging hole to KCC specifications.

Date 12 February 1986 Signature of Operator or Agent Title Operator

For KCC Use:

Conductor Pipe Required feet; Minimum Surface Pipe Required 250 feet per Alt.

This Authorization Expires 8-13-86 Approved By 2-13-86

Ret'd RHB


[Signature]

Must be filed with the K.C.C. five (5) days prior to commencing well  
 This card void if drilling not started within six (6) months of date received by K.C.C.

**Important procedures to follow:**

1. Notify District office before setting surface casing.
2. Set surface casing by circulating cement to the top.
3. File completion forms ACO-1 with K.C.C. within 90 days of well completion, following instructions on ACO-1, side 1, and including copies of wireline logs.
4. Notify District office 48 hours prior to old well workover or re-entry.
5. Prior to filing Intent, prepare a proposed plugging plan in case well is D & A, then obtain approval of plan when calling district office prior to setting surface pipe.
6. Submit plugging report (CP-4) to K. C. C. after plugging is completed.
7. Obtain an approved injection docket number before disposing of salt water.
8. Notify K.C.C. within 10 days when injection commences or terminates.
9. If an alternate 2 completion, cement in the production pipe from below any usable water to surface within 120 days of spud date.

**A Regular Section of Land**  
**1 Mile = 5,280 Ft.**

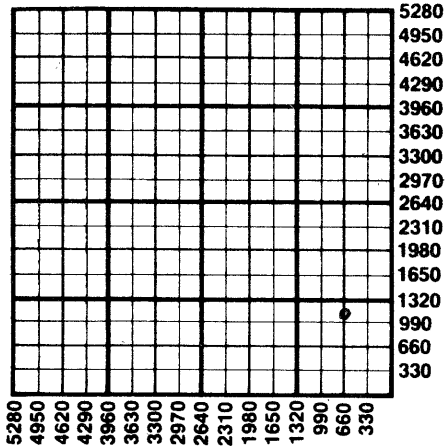

STATE CORPORATION COMMISSION  
 2-13-86  
 FEB 15 1985  
 CONSERVATION DIVISION  
 WICHITA, KANSAS

State Corporation Commission of Kansas  
 Conservation Division  
 200 Colorado Derby Building  
 Wichita, Kansas 67202  
 (316) 263-3238