

EFFECTIVE DATE: 5-30-90 Note: CHANGE IN SPOT LOCATION

CORRECTED

FORM MUST BE TYPED  
FORM C-1 12/88

State of Kansas  
NOTICE OF INTENTION TO DRILL

FORM MUST BE SIGNED  
ALL BLANKS MUST BE FILLED

Must be approved by the K.C.C. five (5) days prior to commencing well

Expected Spud Date May 30, 1990 \* SE NW Sec 33: Twp 1 S, Rg 35 East  
month day year \* West

OPERATOR: License # 5140  
Name: FRONTIER OIL COMPANY  
Address: 125 N. Market, Ste. 1720  
City/State/Zip: Wichita, KS 67202  
Contact Person: Mr. George A. Angle  
Phone: 316-263-1201

\* 3300 feet from South line of Section  
\* 3300 feet from East line of Section  
(Note: Locate well on Section Plat Below)

CONTRACTOR: License #: 5302  
Name: RED TIGER DRILLING CO.

County: Rawlins  
Lease Name: Reeh Well #: 3  
Field Name: Wildcat

Well Drilled For: Well Class: Type Equipment:  
 Oil ... Inj ... Infield  Mud Rotary  
... Gas ... Storage ... Pool Ext. ... Air Rotary  
... OWMO ... Disposal  Wildcat ... Cable  
... Seismic; ... # of Holes

Is this a Prorated Field? ... yes  no  
Target Formation(s): BKC  
Nearest lease or unit boundary: 330  
Ground Surface Elevation: N/A feet MSL

If OWMO: old well information as follows:  
Operator: .....  
Well Name: .....  
Comp. Date: ..... Old Total Depth .....

Domestic well within 330 feet: ... yes  no  
Municipal well within one mile: ... yes  no  
Depth to bottom of fresh water: 240  
Depth to bottom of usable water: 260  
Surface Pipe by Alternate:  1 ... 2  
Length of Surface Pipe Planned to be set: 300  
Length of Conductor pipe required: N/A

Directional, Deviated or Horizontal wellbore? ... yes  no  
If yes, total depth location: .....

Projected Total Depth: 4450  
Formation at Total Depth: BKC  
Water Source for Drilling Operations:  
... well  farm pond ... other

DWR Permit #: .....  
Will Cores Be Taken?: ... yes  no  
If yes, proposed zone: .....

WAS: SE SW; 660 FSL


AFFIDAVIT 15' SE NW; 3300 FSL

The undersigned hereby affirms that the drilling, completion and eventual plugging of this well will comply with K.S.A. 55-101, et. seq.

- It is agreed that the following minimum requirements will be met:
1. The appropriate district office shall be notified before setting surface pipe;
  2. The minimum amount of surface pipe as specified above shall be set by circulating cement to the top; in all cases surface pipe shall be set through all unconsolidated materials plus a minimum of 20 feet into the underlying formation;
  3. If the well is dry, a plugging proposal shall be submitted to the district office. An agreement between the operator and the district office on plug length and placement is necessary prior to plugging;
  4. The appropriate district office will be notified before well is either plugged or production casing is cemented in;
  5. If an Alternate II completion, production pipe shall be cemented from below any usable water to surface within 120 days of spud date. In all cases, notify district office prior to any cementing.

I hereby certify that the statements made herein are true and to the best of my knowledge and belief.

Date: May 29, 1990 Signature of Operator or Agent: D. Ann D. Brennan Rig Coordinator

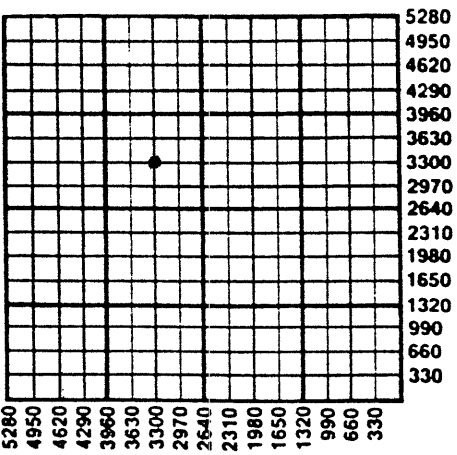

CONSERVATION DIVISION  
Wichita, Kansas

STATE OF KANSAS  
MAY 29 1990  
5-29-90

FOR KCC USE:  
API # 15-153-20,756-00-00  
Conductor pipe required NONE feet  
Minimum surface pipe required 300 feet per Alt. DD  
Approved by: MRW 5/31/90; 5-25-90 DRK  
EFFECTIVE DATE: 5-30-90  
This authorization expires: 12-25-90  
(This authorization void if drilling not started within 6 months of effective date.)  
Spud date: \_\_\_\_\_ Agent: \_\_\_\_\_

33  
1  
35

- REMEMBER TO:
- File Drill Pit Application (form CDP-1) with Intent to Drill;
  - File Completion Form ACO-1 within 120 days of spud date;
  - File acreage attribution plat according to field proration orders;
  - Notify appropriate district office 48 hours prior to workover or re-entry;
  - Submit plugging report (CP-4) after plugging is completed;
  - Obtain written approval before disposing or injecting salt water.