

CARD MUST BE TYPED

State of Kansas

CARD MUST BE SIGNED

NOTICE OF INTENTION TO DRILL

CORRECTED *

Amended Location

(see rules on reverse side)

Expected Spud Date.....6.....21.....88.....
month day year

API Number 15— 023-20,258-00-00-00-00
— East

OPERATOR: License #.....8682.....

* NW. SE. ~~NE~~ Sec. 10... Twp. 1... S, Rg 38..... West

NameGolden Eagle Drilling, Inc.....

Address ..Box 55.....

City/State/ZipMcCook, Nebraska 69001.....

Contact Person.....Darwin Pierson.....

Phone.....308-345-3839.....

.....3630..... Ft. from South Line of Section
*.....990..... Ft. from East Line of Section

(Note: Locate well on Section Plat on reverse side)

CONTRACTOR: License #.....8682.....

* Nearest lease or unit boundary line 990..... feet

NameGolden Eagle Drilling, Inc.....

City/State.... McCook, Nebraska 69001.....

County.....Cheyenne.....

Lease Name.....Christensen * Well # 10-18.....

Ground surface elevation3031..... feet MSL

Domestic well within 330 feet: _____yes no

Municipal well within one mile: _____yes no

Well Drilled For: Well Class: Type Equipment:

Oil _____ Storage _____ Infield Mud Rotary

_____ Gas _____ Inj Pool Ext. _____ Air Rotary

_____ OWWO _____ Expl _____ Wildcat _____ Cable

Depth to bottom of fresh water.....50'.....

Depth to bottom of usable water50'.....

Surface pipe by Alternate: 1 2 _____

Surface pipe planned to be set150.....

Conductor pipe required

Projected Total Depth500..... feet

Formation.....Granite Wash.....

If OWWO: old well info as follows:

Operator

Well Name

Comp Date..... Old Total Depth.....

I certify that well will comply with K.S.A. 55-101, et seq., plus eventually plugging hole to KCC specifications.

Date 6-10-88..... Signature of Operator or Agent *Darwin Pierson* Title *Pres*.....

For KCC Use:


Conductor Pipe Required feet; Minimum Surface Pipe Required150..... feet per Alt

This Authorization Expires 11-2-88..... Approved By *R.H.H. 5-2-88* 6-14-88

* WAS: NE-SE-NE, 330' FEL, N.L.L. 330', Well #10-17

Must be filed with the K.C.C. five (5) days prior to commencing well
This card void if drilling not started within six (6) months of date received by K.C.C.

A Regular Section of Land
1 Mile = 5,280 Ft.

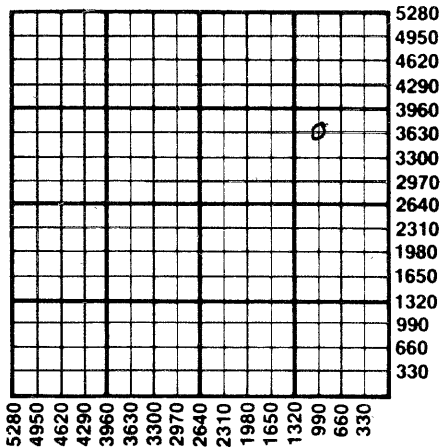

Important procedures to follow:

1. Notify District office before setting surface casing.
2. Set surface casing by circulating cement to the top.
3. File completion forms ACO-1 with K.C.C. within 120 days of well spud date, following instructions on ACO-1, side 1, and including copies of wireline logs.
4. Notify District office 48 hours prior to old well workover or re-entry.
5. Prior to filing Intent, prepare a proposed plugging plan in case well is D & A, then obtain approval of plan when calling district office prior to setting surface pipe.
6. Submit plugging report (CP-4) to K.C.C. after plugging is completed.
7. Obtain an approved injection docket number before disposing of salt water.

8. Notify K.C.C. within 10 days when injection commences or terminates.
9. If an afterflow 2 completion, cement in the production pipe from below any usable water to surface within 120 days of spud date.

RECEIVED
STATE CORPORATION COMMISSION
JUL 13 1988
06-13-1988
CONSERVATION DIVISION
Wichita, Kansas

State Corporation Commission of Kansas
Conservation Division
200 Colorado Derby Building
Wichita, Kansas 67202-1212
(316) 263-3238