

CARD MUST BE TYPED

State of Kansas

CARD MUST BE SIGNED

### NOTICE OF INTENTION TO DRILL

(see rules on reverse side)

Expected Spud Date. April 8 1988  
month day year

API Number 15- 023-20,255-00-00

OPERATOR: License # 8793  
Name James Dillie  
Address 4469 So. Winona Ct,  
City/State/Zip Denver, Colo. 80236  
Contact Person James Dillie  
Phone 303-795-2955

SW SW SW Sec. 2 Twp. 1 S, Rg. 38 XX East West  
330 Ft. from South Line of Section  
4950 Ft. from East Line of Section

CONTRACTOR: License # N/A  
Name Unknown at this time  
City/State .....

(Note: Locate well on Section Plat on reverse side)  
Nearest lease or unit boundary line 330 feet  
County Cheyenne  
Lease Name O'Brien Well # 1-D

Well Drilled For: Well Class: Type Equipment:  
XX Oil XX Storage XX Infield XX Mud Rotary  
    Gas     Inj XX Pool Ext.     Air Rotary  
    OWWO     Expl     Wildcat     Cable

Ground surface elevation 3035 (est) feet MSL  
Domestic well within 330 feet:     yes XX no  
Municipal well within one mile:     yes XX no

If OWWO: old well info as follows:

Operator .....

Well Name .....

Comp Date ..... Old Total Depth .....

Depth to bottom of fresh water: 100'  
Depth to bottom of usable water: 100'  
Surface pipe by Alternate: 160' 1XX 2  
Surface pipe planned to be set: N/A  
Conductor pipe required .....

I certify that well will comply with K.S.A. 55-101, et seq., plus eventually plugging hole to KCC specifications.

Date 3/29/88 Signature of Operator or Agent James Dillie

Projected Total Depth 4570 feet  
Formation Cherokee

For KCC Use:

Conductor Pipe Required ..... feet; Minimum Surface Pipe Required ..... 150 feet per Alt. 1X  
This Authorization Expires: 10-4-88 Approved By: Rt 4-4-88


EFFECTIVE DATE: 4-9-88

Must be filed with the K.C.C. five (5) days prior to commencing well  
 This card void if drilling not started within six (6) months of date received by K.C.C.

**Important procedures to follow:**

1. Notify District office before setting surface casing.
2. Set surface casing by circulating cement to the top.
3. File completion forms ACO-1 with K.C.C. within 120 days of well spud date, following instructions on ACO-1, side 1, and including copies of wireline logs.
4. Notify District office 48 hours prior to old well workover or re-entry.
5. Prior to filing Intent, prepare a proposed plugging plan in case well is D & A, then obtain approval of plan when calling district office prior to setting surface pipe.
6. Submit plugging report (CP-4) to K.C.C. after plugging is completed.
7. Obtain an approved injection docket number before disposing of salt water.
8. Notify K.C.C. within 10 days when injection commences or terminates.
9. If in alternate 2 completion, cement in the production pipe from below any usable water to surface within 120 days of spud date.

**A Regular Section of Land**  
**1 Mile = 5,280 Ft.**

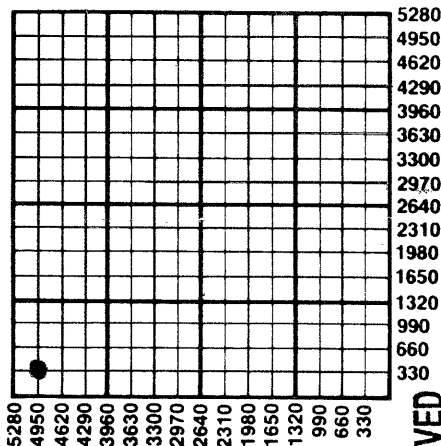

**RECEIVED**  
**STATE CORPORATION COMMISSION**  
**04-04-1988**  
**APR - 4 1988**

**CONSERVATION DIVISION**  
**Wichita, Kansas**

State Corporation Commission of Kansas  
 Conservation Division  
 200 Colorado Derby Building  
 Wichita, Kansas 67202-1212  
 (316) 263-3238