

CARD MUST BE TYPED

State of Kansas

CARD MUST BE SIGNED

# NOTICE OF INTENTION TO DRILL

(see rules on reverse side)

IDA

Expected Spud Date. 10.....17.....88.....  
month day year

API Number 15— 023-20,263-00-00

OPERATOR: License # 8682  
Name Golden Eagle Drilling Inc.  
Address Box 55  
City/State/Zip McCook, Nebr. 69001  
Contact Person Darwin Pierson  
Phone 308-345-3839

SW NW SE ..... Sec. 3 ..... Twp. 1 ..... S, Rg. 38 .....  East  
1650 .....  West  
2310 ..... Ft. from South Line of Section  
..... Ft. from East Line of Section

(Note: Locate well on Section Plat on reverse side)

CONTRACTOR: License # 8682  
Name Golden Eagle Drilling Inc.  
City/State McCook, Ne. 69001

Nearest lease or unit boundary line ..... feet  
County Cheyenne  
Lease Name Haines Well # 3-20

Well Drilled For: Well Class: Type Equipment:  
 Oil  Storage  Infield  Mud Rotary  
 Gas  Inj  Pool Ext.  Air Rotary  
 OWWO  Expl  Wildcat  Cable

Ground surface elevation 3021 ..... feet MSL

Domestic well within 330 feet:  yes  no

Municipal well within one mile:  yes  no

Depth to bottom of fresh water 60' .....

Depth to bottom of usable water 100' .....

Surface pipe by Alternate: 1  2

Surface pipe planned to be set 150 .....

Conductor pipe required no .....

Projected Total Depth 4750 ..... feet

Formation Cherokee .....

If OWWO: old well info as follows:

Operator .....

Well Name .....

Comp Date ..... Old Total Depth .....

I certify that well will comply with K.S.A. 55-101, et seq., plus eventually plugging hole to KCC specifications.

Date 10-10-88 ..... Signature of Operator or Agent Darwin Pierson Title Dar

For KCC Use:

Conductor Pipe Required ..... feet; Minimum Surface Pipe Required 150' ..... feet per Alt.

This Authorization Expires 4-12-89 ..... Approved By LRM 10-12-88

EFFECTIVE DATE: 10-17-88


Must be filed with the K.C.C. five (5) days prior to commencing well  
This card void if drilling not started within six (6) months of date received by K.C.C.

**Important procedures to follow:**

1. Notify District office before setting surface casing.
  2. Set surface casing by circulating cement to the top.
  3. File completion forms ACO-1 with K.C.C. within 120 days of well spud date, following instructions on ACO-1, side 1, and including copies of wireline logs.
  4. Notify District office 48 hours prior to old well workover or re-entry.
  5. Prior to filing Intent, prepare a proposed plugging plan in case well is D & A, then obtain approval of plan when calling district office prior to setting surface pipe.
  6. Submit plugging report (CP-4) to K.C.C. after plugging is completed.
  7. Obtain an approved injection docket number before disposing of salt water.
- Notify K.C.C. within 10 days when injection commences or terminates.

If an alternate 2 completion, cement in the production pipe from below any usable water to surface within 120 days of spud date.

**A Regular Section of Land  
1 Mile = 5,280 Ft.**

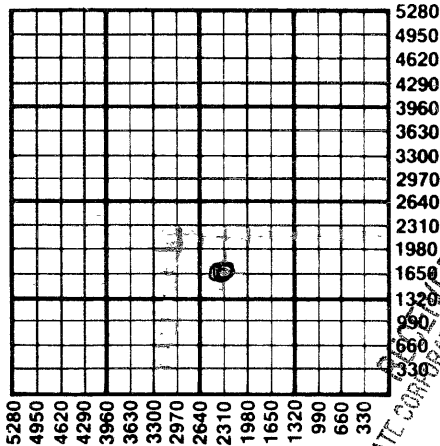

FILED  
OCT 12 1988  
10-12-1988  
STATE CORPORATION COMMISSION  
CONSERVATION DIVISION  
Wichita, Kansas

State Corporation Commission of Kansas  
Conservation Division  
200 Colorado Derby Building  
Wichita, Kansas 67202-1212  
(316) 263-3238