

CARD MUST BE TYPED

State of Kansas

CARD MUST BE SIGNED

NOTICE OF INTENTION TO DRILL

CORRECTION X

CORRECTED INTENT

(see rules on reverse side)

Expected Spud Date. 3-13-88 month day year

API Number 15- 023-20, 253-00-00

OPERATOR: License # 8682
Name Golden Eagle Drilling
Address P.O. Box 55
City/State/Zip McCook, Nebraska 69001
Contact Person Darwin Pierson
Phone (308) 345-3839

SE. NW. NE Sec. 10. Twp. 1. S, Rg. 38. West
4290 Ft. from South Line of Section
1650 Ft. from East Line of Section

CONTRACTOR: License # 8682
Name Golden Eagle Drilling
City/State McCook, Nebraska 69001

(Note: Locate well on Section Plat on reverse side)
Nearest lease or unit boundary line 990 feet
County Cheyenne
Lease Name Christensen Well # 10-2
Ground surface elevation 3031 feet MSL
Domestic well within 330 feet: yes no

Well Drilled For: Well Class: Type Equipment:
X Oil Storage Infield X Mud Rotary
Gas Inj Pool Ext. Air Rotary
OWWO Expl Wildcat Cable

Municipal well within one mile: yes no
Depth to bottom of fresh water 50'
Depth to bottom of usable water 50'
Surface pipe by Alternate: 1 X 2
Surface pipe planned to be set 150'

If OWWO: old well info as follows:
Operator
Well Name
Comp Date Old Total Depth

Conductor pipe required
Projected Total Depth 5000 feet
Formation Granite Wash

I certify that well will comply with K.S.A. 55-101, et seq., plus eventually plugging hole to KCC specifications.
Date 3-14-88 Signature of Operator or Agent Darwin Pierson Title Agent

For KCC Use:
Conductor Pipe Required feet; Minimum Surface Pipe Required 150 feet per Alt. (1) X

This Authorization Expires 9-11-88 Approved By 9-11-88


*WAS C NW-NE 4620 FSL 1980 FEL NLL: 660' OR16 RCV'D 3-11-88

Must be filed with the K.C.C. five (5) days prior to commencing well
 This card void if drilling not started within six (6) months of date received by K.C.C.

Important procedures to follow:

1. Notify District office before setting surface casing.
2. Set surface casing by circulating cement to the top.
3. File completion forms ACO-1 with K.C.C. within 120 days of well spud date, following instructions on ACO-1, side 1, and including copies of wireline logs.
4. Notify District office 48 hours prior to old well workover or re-entry.
5. Prior to filing Intent, prepare a proposed plugging plan in case well is D & A, then obtain approval of plan when calling district office prior to setting surface pipe.
6. Submit plugging report (CP-4) to K.C.C. after plugging is completed.
7. Obtain an approved injection docket number before disposing of salt water.

A Regular Section of Land
1 Mile = 5,280 Ft.

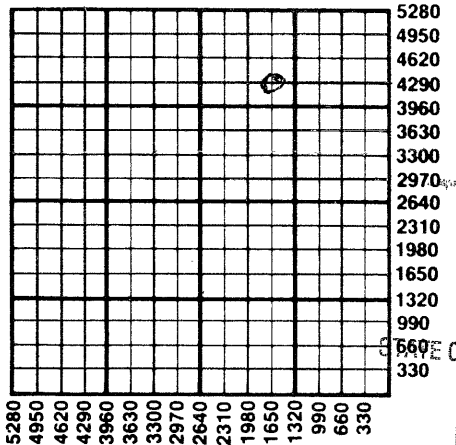

RECEIVED
 STATE CORPORATION COMMISSION

Notify K.C.C. within 10 days when injection commences or terminates.

MAR 16 1988
 03-16-1988
 CONSERVATION DIVISION
 Wichita, Kansas

9. If an alternate 2 completion, cement in the production pipe from below any usable water to surface within 120 days of spud date.

State Corporation Commission of Kansas
 Conservation Division
 200 Colorado Derby Building
 Wichita, Kansas 67202-1212
 (316) 263-3238