

CARD MUST BE TYPED

State of Kansas

CARD MUST BE SIGNED

NOTICE OF INTENTION TO DRILL

(see rules on reverse side)

✓ 10

Expected Spud Date. 3-2-88
month day year

API Number 15— 023-20,252-00-00

OPERATOR: License # 8682
Name Golden Eagle Drilling
Address Box 55
City/State/Zip McCook, NE 69001
Contact Person Darwin Pierson
Phone (308) 345-3839

SE NE NE Sec. 10 Twp. 1 S, Rg. 38 X East West
4290 Ft. from South Line of Section
330 Ft. from East Line of Section

CONTRACTOR: License # 8682
Name Golden Eagle Drilling
City/State McCook, NE 69001

(Note: Locate well on Section Plat on reverse side)
Nearest lease or unit boundary line 330 feet
County Cheyenne
Lease Name Christensen Well # 1

Well Drilled For: Well Class: Type Equipment:
 Oil Storage Infield Mud Rotary
 Gas Inj Pool Ext. Air Rotary
 OWWO Expl Wildcat Cable

Ground surface elevation 2975-3031 feet MSL
Domestic well within 330 feet: yes no
Municipal well within one mile: yes no

If OWWO: old well info as follows:

Operator
Well Name
Comp Date Old Total Depth

Depth to bottom of fresh water 50'
Depth to bottom of usable water 50'
Surface pipe by Alternate: 1 X 2 *

I certify that well will comply with K.S.A. 55-101, et seq., plus eventually plugging hole to KCC specifications.
Date 3-1-88 Signature of Operator or Agent Decker Crawford Title Agent

Surface pipe planned to be set 150' (please call if not acceptable)
Conductor pipe required N/A acceptable
Projected Total Depth 5100 feet
Formation Granite Wash

For KCC Use:

Conductor Pipe Required feet; Minimum Surface Pipe Required 150 feet per Alt. 1 X

This Authorization Expires 8-2-88 Approved By PA 3-2-88


EFFECTIVE DATE: 3-7-88

Must be filed with the K.C.C. five (5) days prior to commencing well
 This card void if drilling not started within six (6) months of date received by K.C.C.

Important procedures to follow:

1. Notify District office before setting surface casing.
2. Set surface casing by circulating cement to the top.
3. File completion forms ACO-1 with K.C.C. within 120 days of well spud date, following instructions on ACO-1, side 1, and including copies of wireline logs.
4. Notify District office 48 hours prior to old well workover or re-entry.
5. Prior to filing Intent, prepare a proposed plugging plan in case well is D & A, then obtain approval of plan when calling district office prior to setting surface pipe.
6. Submit plugging report (CP-4) to K.C.C. after plugging is completed.
7. Obtain an approved injection docket number before disposing of salt water.

A Regular Section of Land
1 Mile = 5,280 Ft.

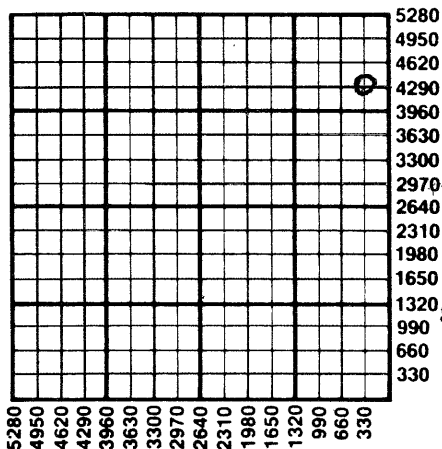

STATE CORPORATION COMMISSION
 03-01-1988
 MAR 1 1988

CONSERVATION DIVISION
 Wichita, Kansas
 If an alternate 2 completion, cement in the production pipe from below any usable water to surface within 120 days of spud date.

State Corporation Commission of Kansas
 Conservation Division
 200 Colorado Derby Building
 Wichita, Kansas 67202-1212
 (316) 263-3238