

CARD MUST BE TYPED

State of Kansas

CARD MUST BE SIGNED

NOTICE OF INTENTION TO DRILL

(Spot Location Correction)

(see rules on reverse side)

Starting Date 7 month 20 day 88 year

API Number 15—

Check For *

023-20,256-00-00

VDF

OPERATOR: License # 5386

Name Production Drilling Inc.

Address P.O. Box 680

City/State/Zip Hays, Kansas 67601

Contact Person Larry Patterson

Phone 913-625-1189

CONTRACTOR: License # 8682

Name Golden Eagle Drilling

City/State Box 55 McCook Ne. 69001

Well Drilled For: Well Class: Type Equipment:

Oil SWD Infield Mud Rotary

Gas Inj Pool Ext. Air Rotary

OWWO Expl Wildcat Cable

IF OWWO: old well info as follows:

Operator

Well Name

Comp Date Old Total Depth

I certify that well will comply with K.S.A. 55-101, et seq., plus eventually plugging hole to KCC specifications.

Date 6-13-88 Signature of Operator or Agent [Signature] Title

For KCC Use:

Conductor Pipe Required feet; Minimum Surface Pipe Required feet per Alt. 150

This Authorization Expires 10-20-88 Approved By [Signature] 4-20-88 6-14-88

* C SW SE Sec. 11 Twp. 1 S, Rg. 38 East West

* 660 Ft. from South Line of Section

* 1980 Ft. from East Line of Section

(Note: Locate well on Section Plat on reverse side)

Nearest lease or unit boundary line 660 feet

County Cheyenne

Lease Name Shafer Well # 1

Ground surface elevation feet MSL

Domestic well within 330 feet: yes no

Municipal well within one mile: yes no

Depth to bottom of fresh water

Depth to bottom of usable water 100

Surface pipe by Alternate: 1 2

Surface pipe planned to be set 150

Conductor pipe required 4900

Projected Total Depth feet

Formation Morrow Sand

* WAS: Start Date 4-28-88, NW-SW-NW, 3630 FSL, 4950 FEL, ALL. 330'


(1) (2)

Must be filed with the K.C.C. five (5) days prior to commencing well
This card void if drilling not started within six (6) months of date received by K.C.C.

Important procedures to follow:

1. Notify District office before setting surface casing.
2. Set surface casing by circulating cement to the top.
3. File completion forms ACO-1 with K.C.C. within 90 days of well completion, following instructions on ACO-1, side 1, and including copies of wireline logs.
4. Notify District office 48 hours prior to old well workover or re-entry.
5. Prior to filing Intent, prepare a proposed plugging plan in case well is D & A, then obtain approval of plan when calling district office prior to setting surface pipe.
6. Submit plugging report (CP-4) to K.C.C. after plugging is completed.
7. Obtain approved injection docket number before disposing of salt water.
8. Notify K.C.C. within 10 days when injection commences or terminates.
9. If an alternate 2 completion, cement in the production pipe from below any usable water to surface within 120 days of spud date.

**A Regular Section of Land
1 Mile = 5,280 Ft.**

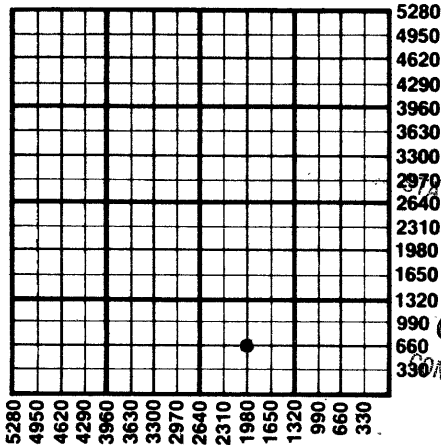

State Corporation Commission of Kansas
Conservation Division
200 Colorado Derby Building
Wichita, Kansas 67202
(316) 263-3238