

CARD MUST BE TYPED

State of Kansas

CARD MUST BE SIGNED

### NOTICE OF INTENTION TO DRILL

(see rules on reverse side)

VDA

Expected Spud Date. 12-9-88  
month day year

API Number 15-023-20,267-00-00

OPERATOR: License #...8682  
Name...Golden Eagle Drilling, Inc.  
Address...P.O. Box 55  
City/State/Zip...McCook, Nebraska 69001  
Contact Person...Darwin Pierson  
Phone...308-345-3839

APR-  
SE. NE. SE. Sec. 14. Twp. 1 S, Rg. 38... East  
16.15 Ft. from South Line of Section  
330 Ft. from East Line of Section

(Note: Locate well on Section Plat on reverse side)

CONTRACTOR: License #...8682  
Name...Golden Eagle Drilling, Inc.  
City/State...McCook, Nebraska 69001

Nearest lease or unit boundary line 330 feet  
County...Cheyenne  
Lease Name...Christensen Well #...14-36

Well Drilled For: Well Class: Type Equipment:  
 Oil  Storage  Infield  Mud Rotary  
 Gas  Inj  Pool Ext.  Air Rotary  
 OWWO  Expl  Wildcat  Cable

Ground surface elevation...3087. Est. 314! feet MSL  
Domestic well within 330 feet:  yes  no  
Municipal well within one mile:  yes  no

If OWWO: old well info as follows:

Depth to bottom of fresh water...100  
Depth to bottom of usable water...100  
Surface pipe by Alternate: 1  2   
Surface pipe planned to be set...150  
Conductor pipe required...NA  
Projected Total Depth...4800 feet  
Formation...Cherokee

Operator  
Well Name  
Comp Date Old Total Depth

I certify that well will comply with K.S.A. 55-101, et seq., plus eventually plugging hole to KCC specifications.

Date Signature of Operator or Agent Darwin Pierson Title

For KCC Use:

Conductor Pipe Required feet; Minimum Surface Pipe Required 150' feet per Alt. 1

This Authorization Expires 6-7-89 Approved By LKM 12-7-88


EFFECTIVE DATE: 12-12-88

Must be filed with the K.C.C. five (5) days prior to commencing well  
This card void if drilling not started within six (6) months of date received by K.C.C.

**Important procedures to follow:**

1. Notify District office before setting surface casing.
2. Set surface casing by circulating cement to the top.
3. File completion forms ACO-1 with K.C.C. within 120 days of well spud date, following instructions on ACO-1, side 1, and including copies of wireline logs.
4. Notify District office 48 hours prior to old well workover or re-entry.
5. Prior to filing Intent, prepare a proposed plugging plan in case well is D & A, then obtain approval of plan when calling district office prior to setting surface pipe.
6. Submit plugging report (CP-4) to K.C.C. after plugging is completed.
7. Obtain an approved injection docket number before disposing of salt water.  
Notify K.C.C. within 10 days when injection commences or terminates.
8. In an alternate 2 completion, cement in the production pipe from below any usable water to surface within 120 days of spud date.

**A Regular Section of Land  
1 Mile = 5,280 Ft.**

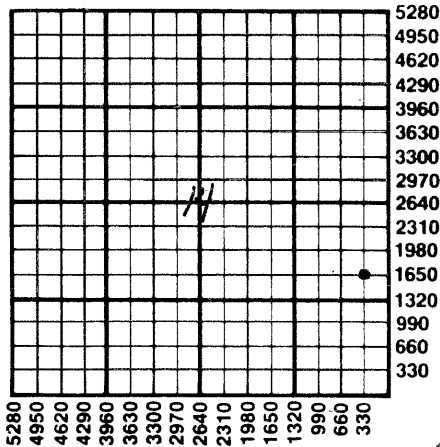

RECEIVED  
STATE CORPORATION COMMISSION  
DEC 7 1998  
CONSERVATION DIVISION  
Wichita, Kansas

State Corporation Commission of Kansas  
Conservation Division  
200 Colorado Derby Building  
Wichita, Kansas 67202-1212  
(316) 263-3238