

Give All Information Completely
Make Required Affidavit
Mail or Deliver Report to:
Conservation Division
State Corporation Commission
800 Bittling Building
Wichita, Kansas


WELL PLUGGING RECORD

15-023-00008-00-00

Cheyenne County, Sec. 10 Twp. 1s. Rge. 38 (E) W (W)

Location as "NE/CNW/SW" or footage from lines C SE SE
Lease Owner Westheimer - Neustadt
Lease Name Glasco Well No. 1
Office Address Box 974, Ardmore, Oklahoma
Character of Well (completed as Oil, Gas or Dry Hole) Dry Hole
Date well completed September 18 1958
Application for plugging filed September 18 1958
Application for plugging approved September 18 1958
Plugging commenced September 18 1958
Plugging completed September 18 1958
Reason for abandonment of well or producing formation Dry Hole

NORTH

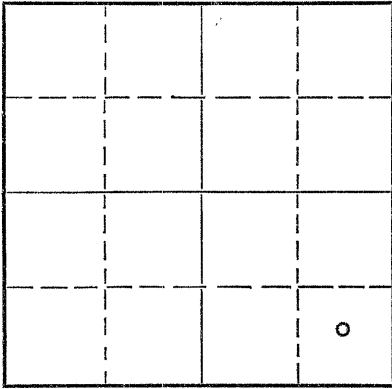

Locate well correctly on above
Section Plat

If a producing well is abandoned, date of last production none 19
Was permission obtained from the Conservation Division or its agents before plugging was commenced? yes

Name of Conservation Agent who supervised plugging of this well A. D. Fabricius
Producing formation none Depth to top Bottom Total Depth of Well 4975 Feet
Show depth and thickness of all water, oil and gas formations.

OIL, GAS OR WATER RECORDS

CASING RECORD

FORMATION	CONTENT	FROM	TO	SIZE	PUT IN	PULLED OUT

Describe in detail the manner in which the well was plugged, indicating where the mud fluid was placed and the method or methods used in introducing it into the hole. If cement or other plugs were used, state the character of same and depth placed, from feet to feet for each plug set.

- Set bottom plug at depth of 600 feet. Spotted 20 sacks cement. Filled hole with heavy mud to depth of 213 feet.
- Set center plug at depth of 213 feet. Dumped in about 1/3 sack hulls. Spotted 20 sacks cement. Filled hole to within 40 feet of top with heavy mud.
- Set top plug at depth of 40 feet. Dumped in about 1/3 sack hulls. Spotted 10 sacks cement.

(If additional description is necessary, use BACK of this sheet)

Name of Plugging Contractor Garvey Drilling Co.
Address Rt. 2, Great Bend, Kansas

STATE OF Kansas, COUNTY OF Sedgwick, ss.
Richard G. Smith (employee of owner) or (~~owner or operator~~) of the above-described well, being first duly sworn on oath, says: That I have knowledge of the facts, statements, and matters herein contained and the log of the above-described well as filed and that the same are true and correct. So help me God.

(Signature) Richard G. Smith

2934 Euclid, Wichita, Kansas
(Address)

SUBSCRIBED AND SWORN TO before me this 24th day of September, 1958

My commission expires 1-24-59

Alta...
Notary Public.

24-7368-S 3-53-20M

STATE CORPORATION COMMISSION
09-30-1958
SEP 30 1958

PLUGGING
FILE SEC 10 T 1 R 38W
BOOK PAGE 132 LINE 41

CONSERVATION DIVISION
Wichita, Kansas

15-023-0000800-00

DRILLERS' LOG

Westheimer - Neustadt

Glasco No. 1

C SE SE Sec. 10 - 1s - 38w
Cheyenne County, Kansas

Elevation: 3085 GL
3087 DF
3090 KB

Rotary Total Depth: 4975

Commenced:
Completed Drilling with Rotary:
Casing: 8-5/8" @ 217

September 6, 1958
September 18, 1958

Contractor: Garvey Drilling Company
Route 2
Great Bend, Kansas

FORMATION

DEPTH

shale	0-1100
sand and shaley sand	1100-1650
shale and sandy shale	1650-2800
anhydrite	2800-2820
shale	2820-2860
sand	2860-2960
sandy shale	2960-3050
anhydrite	3050-3090
sand and shale	3090-3240
anhydrite	3240-3280
lime and shale	3280-3900
shale	3900-3924
lime	3924-4080
shale	4080-4110
lime	4110-4380
shale	4380-4420
lime and shale	4420-4579
shale and sand	4579-4790
cherty lime and dolomite	4790-4920
dolomite	4920-4975

RECEIVED
STATE CORPORATION COMMISSION
09-30-1958
SEP 30 1958
CONSERVATION DIVISION
Wichita, Kansas

PLUGGING

FILE SEC 10 T 1 R 38w
BOOK PAGE 132 LINE 41