

15-023-20039-00-00

FORM CP-4

STATE OF KANSAS  
STATE CORPORATION COMMISSION

WELL PLUGGING RECORD

Give All Information Completely  
Make Required Affidavit  
Mail or Deliver Report to  
Conservation Division  
State Corporation Comm.  
245 North Water  
Wichita, KS 67202

Cheyenne County. Sec. 33 Twp. 1s Rge. 37 ~~NE~~/W  
Location as "NE/CNW $\frac{1}{4}$ SW $\frac{1}{4}$ " or footage from lines  
C NW SW

Lease Owner Vincent Oil Corp.  
Lease Name MEARS Well No. 1  
Office Address 901 Union Center, Wichita, Ks 67202  
Character of Well (Completed as Oil, Gas or Dry Hole)  
Dry Hole


Date Well completed 5/10 1977  
Application for plugging filed 5/10 1977  
Application for plugging approved 5/10 1977  
Plugging commenced 5/10 1977  
Plugging completed 5/10 1977  
Reason for abandonment of well or producing formation  
Dry Hole

If a producing well is abandoned, date of last production  
19

Was permission obtained from the Conservation Division or  
its agents before plugging was commenced? Yes

Name of Conservation Agent who supervised plugging of this well Gilbert Balthezor  
Producing formation Depth to top Bottom Total Depth of Well 4590'

Show depth and thickness of all water, oil and gas formations.

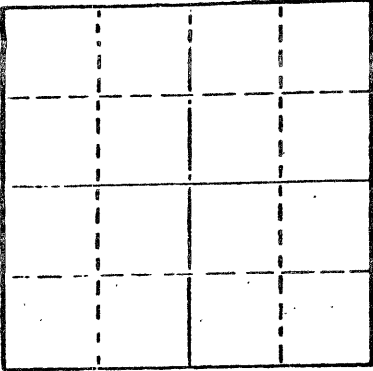

Locate well correctly on above  
Section Plat

OIL, GAS OR WATER RECORDS

CASIN I RECORD

FORMATION	CONTENT	FROM	TO	SIZE	PUT IN	PULLED OUT
				8 5/8"	182'	None

Describe in detail the manner in which the well was plugged, indicating where the mud fluid  
was placed and the method or methods used in introducing it into the hold. If cement or other  
plugs were used, state the character of same and depth placed, from \_\_\_\_\_ feet to  
\_\_\_\_\_ feet for each plug set.

1st plug @ 2000' w/70 sx  
2nd plug @ 140' w/20 sx  
3rd plug @ 40' w/10 sx

RECEIVED  
STATE CORPORATION COMMISSION  
05-20-1977  
MAY 20 1977

CONSERVATION DIVISION  
Wichita, Kansas

(If additional description is necessary, use BACK of this sheet)

Name of Plugging Contractor Halliburton

STATE OF Kansas COUNTY OF Sedgwick ss.  
Wm. S. Shropshire (employee of owner) or (owner or operator) of the above-described  
well, being first duly sworn on oath, says: That I have knowledge of the facts, statements, and matters herein contained and the log of the  
above-described well as filed and that the same are true and correct. So help me God.

(Signature) Wm. S. Shropshire  
617 Union Center, Wichita, Ks 67202  
(Address)

SUBSCRIBED AND SWORN TO before me this 18th day of May 19 77

JOLENE S. FRISBIE, STATE NOTARY PUBLIC  
My Comm. Exp. March 13, 1979

Jolene S. Frisbie  
Notary Public.



WELL LOG

15-023-20039-00-00

COMPANY Vincent Oil Corp.

SEC. 33 T. 1S R. 37W  
LOC. C NW SW

FARM MEARS NO. 1


RIG. NO. 3

TOTAL DEPTH 4590'

COMM. 5/3/77

COMP. 5/10/77

COUNTY Cheyenne  
KANSAS

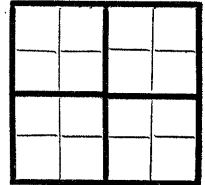

CONTRACTOR Murfin Drilling

CASING

20 10  
15 8 5/8" @ 182' w/250 sx  
12 6  
13 5

ELEVATION

PRODUCTION D&A

FIGURES INDICATE BOTTOM OF FORMATIONS

135 clay, sand  
1440 shale  
2735 shale, sand  
2785 sand  
2945 shale, chert  
3090 sand, shale  
3104 Blaine  
3300 shale, sand  
3510 shale  
4590 lime, shale  
4590 RTD

RECEIVED  
STATE CORPORATION COMMISSION

MAY 20 1977

CONSERVATION DIVISION  
Wichita, Kansas

State of Kansas  
County of Sedgwick } ss:

I, Wm. S. Shropshire of the Murfin Drilling Company

upon oath state that the above and foregoing is a true and correct copy of the log of the MEARS #1 well.

Wm. S. Shropshire

Subscribed and sworn to before me this 18th day of May 19 77

JOLENE S. FRISBIE, STATE NOTARY PUBLIC

My Commission Expires: My Comm. Exp. March 13, 1979

Jolene S. Frisbie  
NOTARY PUBLIC

