

CARD MUST BE TYPED

State of Kansas  
**NOTICE OF INTENTION TO DRILL**  
(see rules on reverse side)

CARD MUST BE SIGNED

Starting Date: February 18, 1986  
month day year

API Number 15- 183-20, 013-00-00 <sup>DA</sup>

OPERATOR: License # 4065

SE. SE SE. Sec. 5. Twp. 2. S, Rge 14.  East  West  
(location)

Name Energy Oil, Inc.

Address 1960 Industrial Circle

City/State/Zip Longmont, CO 80501

Contact Person Charles W. Gale, Drilling Supervisor

Phone (303) 776-4354

330 Ft North from Southeast Corner of Section

330 Ft West from Southeast Corner of Section

(Note: Locate well on Section Plat on reverse side)

CONTRACTOR: License # 6394

Nearest lease or unit boundary line 330' feet.

County Smith

Name Mohawk Drilling

Lease Name Lyon Well# 1

City/State Great Bend, Kansas

Domestic well within 330 feet:  yes  no

Municipal well within one mile:  yes  no

Well Drilled For: Well Class: Type Equipment:

- Oil  Swd  Infield  Mud Rotary
- Gas  Inj  Pool Ext.  Air Rotary
- OWWO  Expl  Wildcat  Cable

Depth to Bottom of fresh water 260' ~~1100'~~ (Dakota) feet

Lowest usable water formation 200' ~~250'~~ Dakota feet

Depth to Bottom of usable water 200' ~~250'~~ 1100' feet

Surface pipe by Alternate: 1  2  feet

Surface pipe to be set 250' minimum feet

Conductor pipe if any required feet

Ground surface elevation 2025 feet MSL

This Authorization Expires 8-14-86

Approved By [Signature]

If OWWO: old well info as follows:

Operator

Well Name

Comp Date Old Total Depth

Projected Total Depth 4600' feet

Projected Formation at TD Arbuckle

Expected Producing Formations unknown/wildcat

I certify that we will comply with K.S.A. 55-101, et seq., plus eventually plugging hole to K.C.C. specifications.

Date 2/11/86 Signature of Operator or Agent

[Signature] Charles W. Gale Title

[Signature] Drilling Supervisor


pen/10/86

Form 14/84

**Must be filed with the K.C.C. five (5) days prior to commencing well  
This card void if drilling not started within six (6) months of date received by K.C.C.**

**Important procedures to follow :**

**A Regular Section of Land  
1 Mile = 5,280 Ft.**

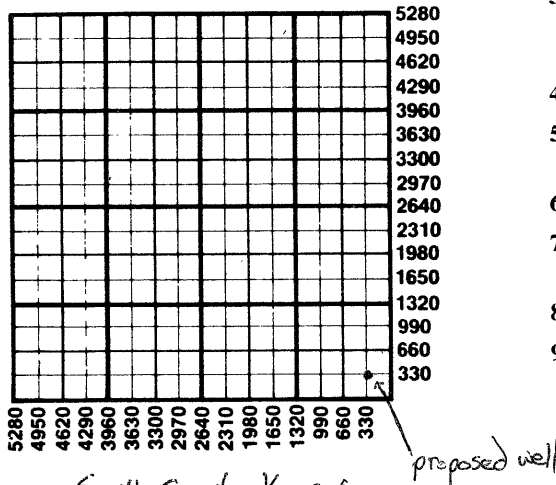

*Smith County, Kansas  
T25 R14W  
Sec. 5: SE4 SE9 SE4*

1. Notify District office before setting surface casing.
2. Set surface casing by circulating cement to the top.
3. File completion forms ACO-1 with K.C.C. within 90 days of well completion, following instructions on ACO-1, side 1, and including copies of wireline logs.
4. Notify District office 48 hours prior to old well workover or re-entry.
5. Prior to plugging, prepare a plugging plan, then obtain agreement from the appropriate district office for an approved plugging plan.
6. Submit plugging report (CP-4) to K.C.C. after plugging is completed.
7. Obtain an approved injection docket number before disposing of salt water.
8. Notify K.C.C. within 10 days when injection commences or terminates.
9. If an alternate 2 completion, cement in the production pipe from below any usable water to surface within 120 days of spud date.

**State Corporation Commission of Kansas**  
**Conservation Division**  
**200 Colorado Derby Building**  
**Wichita, Kansas 67202**  
**(316) 263-3238**

**FEB 14 1993**  
**2-14-86**  
**CONSERVATION DIVISION**  
 WICHITA, KANSAS