

19-023-00001-00-00


STATE OF KANSAS
STATE CORPORATION COMMISSION

WELL PLUGGING RECORD

Give All Information Completely
Make Required Affidavit
Mail or Deliver Report to:
Conservation Division
State Corporation Commission
800 Bitting Building
Wichita, Kansas

Cheyenne County. Sec. 23 Twp. 1S Rge. 42 (E) W (W)

Location as "NE/CNW $\frac{1}{4}$ SW $\frac{1}{4}$ " or footage from lines C SW SW Sw
Lease Owner Deep Rock Oil Corporation
Lease Name A. J. Clark Well No. 1
Office Address Box 1051, Tulsa, Oklahoma
Character of Well (completed as Oil, Gas or Dry Hole) Dry Hole
Date well completed July 25, 19 52
Application for plugging filed July 24, 19 52
Application for plugging approved July 26, 19 52
Plugging commenced July 25, 19 52
Plugging completed July 25, 19 52
Reason for abandonment of well or producing formation Dry Hole

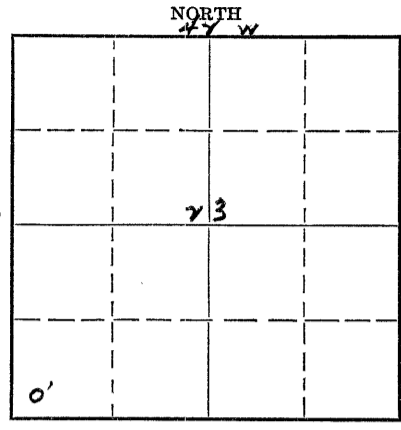

Locate well correctly on above
Section Plat

If a producing well is abandoned, date of last production 19...
Was permission obtained from the Conservation Division or its agents before plugging was commenced? Yes

Name of Conservation Agent who supervised plugging of this well Mr. Eldon Petty
Producing formation Depth to top Bottom Total Depth of Well 5632 Feet
Show depth and thickness of all water, oil and gas formations.

OIL, GAS OR WATER RECORDS

CASING RECORD

Formation	Content	From	To	Size	Put In	Pulled Out
				10 3/4"	342	None

Describe in detail the manner in which the well was plugged, indicating where the mud fluid was placed and the method or methods used in introducing it into the hole. If cement or other plugs were used, state the character of same and depth placed, from...feet to ...feet for each plug set.

Filled Hole with heavy mud to 300'. Set Wood plug and pumped in 20 sacks cement. Filled to 30' with heavy mud. Set wood plug at 30' and pumped in 10 sacks cement to top of pipe and into cellar.

(If additional description is necessary, use BACK of this sheet)

Name of Plugging Contractor Gabbert-Jones Drilling Co.
Address 507 Orpheum Building, Wichita, Kansas

STATE OF KANSAS, COUNTY OF RENO, ss.
R.D. Michaels (employee of owner) or (owner/operator) of the above-described well,

being first duly sworn on oath, says: That I have knowledge of the facts, statements, and matters herein contained and the log of the above-described well as filed and that the same are true and correct. So help me God.

(Signature) R.D. Michaels
Dist. Engineer

Box #1146, Hutchinson, Kansas (Address)

SUBSCRIBED AND SWORN to before me this 20th day of August, 19 52

Notary Public

My commission expires September 28, 1952

23-8890-s 6-51-20M

PLUGGING
FILE SEC 23 T 1 R 20
BOOK PAGE 32 LINE 17

STATE CORP...
CONSERVATION DIVISION
Wichita, Kansas
8-21-52

15-023-00001-06-00

GABBERT-JONES DRILLING COMPANY
WICHITA, KANSAS
DRILLER'S WELL LOG

Clark #1
SW SW SW, Sec. 23-1-42W
Cheyenne County, Kansas

Commenced 6-12-52
Completed 7-25-52

Depth		Formation	Remarks
From	To		
0	130	Surface clay & shale	Ran 343' of 10 3/4" casing, cemented w/200 sacks cement.
130	344	Blue Shale	
344	1490	Shale	
1490	2050	Shale & sand	
2050	2450	Shale	
2450	2575	Shale & sand	
2575	2625	Shale	
2625	2720	Shale & lime	
2720	2815	Shale & sand	
2815	2850	Shale	
2850	3000	Shale & lime	
3000	3070	Shale	
3070	3250	Shale & lime	
3250	3580	Shale & shells	
3580	3625	Red Bed & shale	
3625	3712	Shale & shells	
3712	3765	Lime	
3765	3990	Lime & shale	
3990	4020	Lime	
4020	4060	Broken lime & shale	
4060	4188	Lime	
4188	4234	Lime & shale	
4234	4250	Shale	
4250	4545	Lime	
4545	4566	Lime & shale	
4566	4575	Shale	
4575	4995	Lime	
4995	5043	Shale	
5043	5273	Lime	
5273	5285	Lime & shale	
5285	5465	Lime	
5465	5495	Lime & sand	
5495	5532	Sand	
5532	5560	Sand & lime	
5560	5580	Sand	
5580	5592	Sand & chert	
5592	5619	Sand	
5619	5632	Chert & granite	
5632	TD		



PLUGGING
FILE SEC 23-1-R-462
BOOK PAGE 32 LINE 17

Dry & abandoned 8-21-52

EXECUTE this 29th day of July, 1952

C. L. Gabbert
Wichita, Kansas

STATE OF KANSAS)
) ss ACKNOWLEDGMENT FOR INDIVIDUAL
COUNTY OF SEDGWICK)

Before me, the undersigned, a Notary Public, within and for said county and State, on this 29th day of July, 1952, personally appeared C. L. Gabbert to me personally known to be the identical person who executed the within and foregoing instrument and acknowledged to me that he executed the same as his free and voluntary act and deed for the uses and purposes therein set forth.

IN WITNESS WHEREOF, I have hereunto set my hand and official seal the day and year last above written.

My commission expires 10-27-54

Summit & Hall
Notary Public