


15-023-20037-0000

STATE OF KANSAS
STATE CORPORATION COMMISSION

WELL PLUGGING RECORD

Give All Information Completely
Make Required Affidavit
Mail or Deliver Report to
Conservation Division
State Corporation Comm.
245 North Water
Wichita, KS 67202

Cheyenne County. Sec. 34 Twp. 18 Rge. 41 E/W
Location as "NE/CNW 1/4 SW 1/4" or footage from lines _____
710' FEL & 720' FNL
Lease Owner J-W Operating Company
Lease Name Hanna Klinzman Well No. 1
Office Address 518 Praetorian Building, Dallas, TX 75201
Character of Well (Completed as Oil, Gas or Dry Hole) _____
Dry Hole
Date Well completed _____ 4-30- 1977
Application for plugging filed _____ 5-11- 1977
Application for plugging approved (Verbal) _____ 4-30- 1977
Plugging commenced _____ 4-30- 1977
Plugging completed _____ 5-1- 1977
Reason for abandonment of well or producing formation _____
Dry
If a producing well is abandoned, date of last production _____ 19

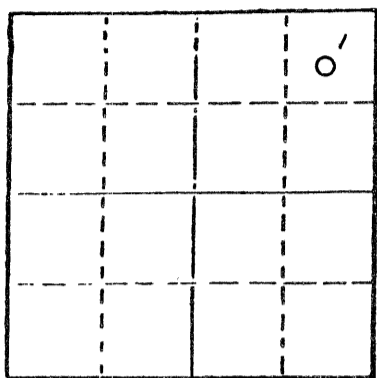

Locate well correctly on above
Section Plat

Name of Conservation Agent who supervised plugging of this well Gilbert Balthazer
Producing formation None Depth to top _____ Bottom _____ Total Depth of Well 1992
Show depth and thickness of all water, oil and gas formations.

OIL, GAS OR WATER RECORDS

CASING RECORD

FORMATION	CONTENT	FROM	TO	SIZE	PUT IN	PULLED OUT
				8-5/8	259'	None
Niobrara	Water	1505	1555			
Niobrara	Water	1760	1794			
Niobrara	Water	1898	1938			

Describe in detail the manner in which the well was plugged, indicating where the mud fluid was placed and the method or methods used in introducing it into the hold. If cement or other plugs were used, state the character of same and depth placed, from _____ feet to _____ feet for each plug set.

70 sacks 50-50 Pozmix - 6% Gel 1992' - 1692'
Mud 1692' - 240'
20 sacks 50-50 Pozmix - 6% Gel 240' - 160'
Mud 160' - 40'
10 sacks 50-50 Pozmix - 6% Gel 40' - Surface

Method - Pump

RECEIVED
STATE CORPORATION COMMISSION
JUN 08 1977
KANSAS STATE CORPORATION COMMISSION
Wichita, Kansas

6-8-77

(If additional description is necessary, use BACK of this sheet)

Name of Plugging Contractor Exeter Drilling Company

STATE OF TEXAS COUNTY OF DALLAS, ss.
Wm. J. Mannas, employee of J-W Operating Company (employee of owner) or (owner or operator) of the above-described well, being first duly sworn on oath, says: That I have knowledge of the facts, statements, and matters herein contained and the log of the above-described well as filed and that the same are true and correct. So help me God.

(Signature) Wm J Mannas
518 Praetorian Building, Dallas, Texas 75201
(Address)

SUBSCRIBED AND SWORN TO before me this 2nd day of June, 1977

Priscilla K. Kinkaid
PRISCILLA K. KINKAID, Notary Public Notary Public.
in and for Dallas County, Texas
My commission expires 8-5-78

My commission expires August 5, 1978