


15-023-20036-00-00

STATE OF KANSAS
STATE CORPORATION COMMISSION

WELL PLUGGING RECORD

Give All Information Completely
Make Required Affidavit
Mail or Deliver Report to
Conservation Division
State Corporation Comm.
245 North Water
Wichita, KS 67202

Cheyenne County. Sec. 23 Twp. 1S Rge. 41 E/W
Location as "NE/CNW $\frac{1}{4}$ SW $\frac{1}{4}$ " or footage from lines
660' FWL & 820' FNL
Lease Owner J-W Operating Company
Lease Name Louisa B. Rose Well No. 1
Office Address 518 Praetorian Building, Dallas, TX 75201
Character of Well (Completed as Oil, Gas or Dry Hole)

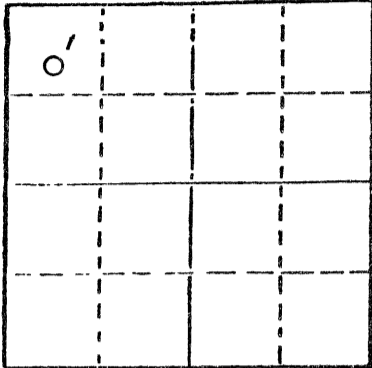

Locate well correctly on above
Section Plat

Dry Hole
Date Well completed 4-29- 1977
Application for plugging filed 5-11- 1977
Application for plugging approved (Verbal) 4-29- 1977
Plugging commenced 4-29- 1977
Plugging completed 4-29- 1977
Reason for abandonment of well or producing formation

Dry
If a producing well is abandoned, date of last production 19

Was permission obtained from the Conservation Division or its agents before plugging was commenced? Yes

Name of Conservation Agent who supervised plugging of this well Gilbert Balthazer
Producing formation None Depth to top Bottom Total Depth of Well 2119
Show depth and thickness of all water, oil and gas formations.

OIL, GAS OR WATER RECORDS

CASING RECORD

FORMATION	CONTENT	FROM	TO	SIZE	PUT IN	PULLED OUT
				8-5/8	258'	None
Niobrara	Water	1604	1666			
Niobrara	Water	1878	1912			
Niobrara	Water	2013	2054			

Describe in detail the manner in which the well was plugged, indicating where the mud fluid was placed and the method or methods used in introducing it into the hold. If cement or other plugs were used, state the character of same and depth placed, from feet to feet for each plug set.

70 sacks 50-50 Pozmix Cement	2119' - 1819'
Mud	1819' - 240'
20 sacks 50-50 Pozmix Cement	240' - 160'
Mud	160' - 40'
10 sacks 50-50 Pozmix Cement	40' - Surface

Method - Pump

RECEIVED
STATE CORPORATION COMMISSION
JUN 08 1977
CONSERVATION DIVISION
Wichita, Kansas
6-8-77

(If additional description is necessary, use BACK of this sheet)

Name of Plugging Contractor Cementers Inc.

STATE OF Texas COUNTY OF Dallas, ss.
Wm. J. Mannas, employee of operator (employee of owner) or (owner or operator)
of the above-described well, being first duly sworn on oath, says: That I have knowledge of the facts, statements, and matters herein contained and the log of the above-described well as filed and that the same are true and correct. So help me God.

(Signature) Wm. J. Mannas
518 Praetorian Building, Dallas, Texas 75201
(Address)

SUBSCRIBED AND SWORN TO before me this 2nd day of June, 1977

My commission expires August 5, 1978

Priscilla K. Kinkaid
PRISCILLA K. KINKAID, Notary Public Notary Public.
in and for Dallas County, Texas
My commission expires 8-5-78