


STATE OF KANSAS  
STATE CORPORATION COMMISSION

15-023-00015-00-00  
WELL PLUGGING RECORD

Give All Information Completely  
Make Required Affidavit  
Mail or Deliver Report to:  
Conservation Division  
State Corporation Commission  
800 Bittling Building  
Wichita, Kansas

Cheyenne County, Sec. 26 Twp. 1 Rge. 29 (X) (W)

NORTH

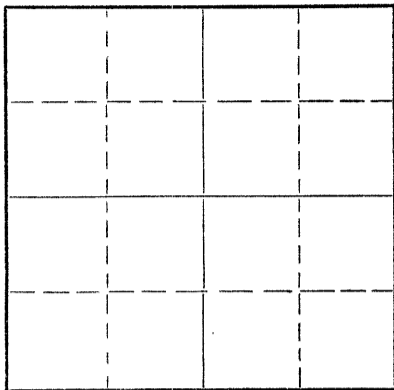

Locate well correctly on above  
Section Plat

Location as "NE/CNW $\frac{1}{4}$ SW $\frac{1}{4}$ " or footage from lines SE SE NW

Lease Owner Ben F. Brack Oil Company, Inc.

Lease Name Judy Well No. 1

Office Address 309 Brown Bldg., Wichita 2, Kansas

Character of Well (completed as Oil, Gas or Dry Hole) D&S Oil

Date well completed 7-19-51 19

Application for plugging filed 2-4-53 19

Application for plugging approved 2-4-53 19

Plugging commenced 2-4-53 19

Plugging completed 2-7-53 19

Reason for abandonment of well or producing formation D&S

If a producing well is abandoned, date of last production 1-5-52 19

Was permission obtained from the Conservation Division or its agents before plugging was commenced? Yes

Name of Conservation Agent who supervised plugging of this well Eldon Petty

Producing formation Kansas City Lime Depth to top 4180' Bottom 4305' Total Depth of Well 5141' Feet

Show depth and thickness of all water, oil and gas formations.

OIL, GAS OR WATER RECORDS

CASING RECORD

FORMATION	CONTENT	FROM	TO	SIZE	PUT IN	PULLED OUT
Surface soil, sand & gravel	dry	0'	124'	10 3/4	124'	None
Lime & shale & lime streaks	water & oil	4180'	5141'	5 1/2	4754'	2321'

Describe in detail the manner in which the well was plugged, indicating where the mud fluid was placed and the method or methods used in introducing it into the hole. If cement or other plugs were used, state the character of same and depth placed, from 4475 feet to 124 feet for each plug set.

Permanent rock bridge 4475'-4443'; filled hole with heavy mud from 4443' to 124'; 114'-124' permanent rock bridge; 114'-74' - 20 sax cement; 74'-30' - heavy mud; 30'-25' - rock bridge; 25' to bottom of cellar - 10 sax cement.

RECEIVED  
STATE CORPORATION COMMISSION  
FEB 20 1953  
CONSERVATION DIVISION  
Wichita, Kansas

2-20-53

(If additional description is necessary, use BACK of this sheet)

Name of Plugging Contractor Pipe Pulling, Inc.  
Address 629 West Broadway, Stafford, Kansas

STATE OF KANSAS, COUNTY OF SEDGWICK, ss.  
Leland E. Brack (employee of owner) or (owner or operator) of the above-described

well, being first duly sworn on oath, says: That I have knowledge of the facts, statements, and matters herein contained and the log of the above-described well as filed and that the same are true and correct. So help me God.


(Signature) Leland E. Brack

309 Brown Bldg., Wichita 2, Kansas (Address)

Subscribed and sworn to before me this 18th day of February, 1953

My commission expires June 11, 1955

Notary Public.

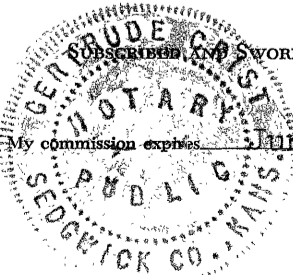

PLUGGING  
FILE SEC 26 T 1 R 3924  
BOOK PAGE 18 LINE 55

15-023-00015-00-00

BEN F. BRACK OIL COMPANY, INC.  
309-10 Brown Building  
Wichita 2, Kansas

JUDY NO. 1

SE SE NW

Sec. 26-1 S-39 W  
Cheyenne County, Ks.

Commenced: April 7, 1951  
Completed: May 21, 1951

Elevation: 3122 Kelly  
Bushing

WELL LOG

Surface	0 - 124
Sand - Shale	530
Shale	1335
Shale - Lime	1825
Sand - Shale	2200
Shale - Sand	2440
Sand - Shale	2615
Shale - Sand	2700
Sand - Shale	2765
Sand	2825
Anhydrite - Sand	2875
Anhydrite - Shale	2935
Anhydrite - Sand - Red Bed	3055
Red Bed - Trace of Anhydrite	3130
Shale - Shells	3200
Sandy Silt - Shale	3255
Soft Red Shale	3205
Red Shale - Streak of Dolomite	3365
Shale	3375
Shale - Shells	3420
Lime - Shale	3465
Shale - Sand	3500
Dolomite - Sand	3585
Lime	3670
Lime - Sand	3725
Lime - Chert - Sand	3745
Lime	3802
Lime - Sand	3850
Lime - Sand - Shale	3904
Lime	3949
Lime - Shale	4020
Lime	4065
Lime - Shale - Red	4095
Lime	4150
Lime - Shale - Red	4170
Lime	4319
Lime - Chalk, soft	4328
Lime	4385
Lime - broken	4405
Lime - Shale	4455
Broken Lime	4540
Lime	4555
Soft Lime - Trace of Coral	4577
Lime	4690
Sand - Lime	4706
Lime	4767
Lime, broken	4810
Lime	5135
Granite	5141 T.D.

FORMATIONS

Graneros	1909-68
Morrison	2528-63
Lansing	4145
Base K. C.	4389
Marmaton	4489
Cherokee	4625
Mississippi	4855
Arbuckle	5046

CASING RECORD

10-3/4"	124'
5-1/2"	4754

Above depths denote bottom of formation.

To the best of my knowledge the above is a true and correct statement of depths and formations and where found.

**PLUGGING**  
 FILE SEC 26T 1 R 39  
 BOOK PAGE 28 LINE 35

BEN F. BRACK OIL COMPANY, INC.

WITNESSED:

*Velda Harness*

*Emil E. Bowers*  
Emil E. Bowers