

15-023-00009-00-00

STATE OF KANSAS
STATE CORPORATION COMMISSION

WELL PLUGGING RECORD


Give All Information Completely
Make Required Affidavit
Mail or Deliver Report to:
Conservation Division
State Corporation Commission
800 Bitting Building
Wichita, Kansas

OR

FORMATION PLUGGING RECORD

Strike out upper line
when reporting plug-
ging of formations.

Cheyenne County. Sec. 35 Twp. 1 Rge. 39 (W)
Location as "NE $\frac{1}{4}$ NW $\frac{1}{4}$ SW $\frac{1}{4}$ " or footage from lines 330' S of N line, 330' W of
Lease Owner Ben F. Brack Oil Company, Inc. E line
Lease Name Judy Well No. 2
Office Address 309 Brown Bldg., Wichita, Kansas
Character of Well (completed as Oil, Gas or Dry Hole) Dry hole
Date well completed 3-23-52 19____
Application for plugging filed 3-22-52 19____
Application for plugging approved 3-22-52 19____
Plugging commenced 3-23-52 19____
Plugging completed 3-23-52 19____
Reason for abandonment of well or producing formation Dry Hole
If a producing well is abandoned, date of last production _____ 19____
Was permission obtained from the Conservation Division or its agents before plugging was com-
menced? Yes, verbally

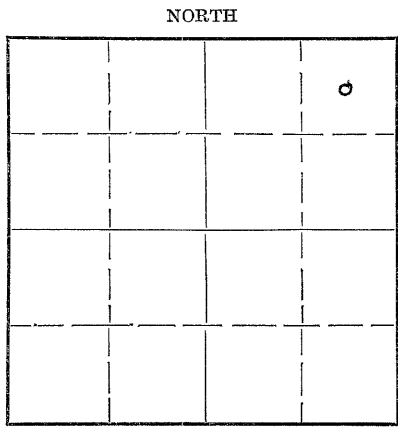

Locate well correctly on above
Section Plat

Name of Conservation Agent who supervised plugging of this well C. D. Stough
Producing formation None Depth to top _____ Bottom _____ Total Depth of Well 4963 Feet
Show depth and thickness of all water, oil and gas formations.

OIL, GAS OR WATER RECORDS

CASING RECORD

Formation	Content	From	To	Size	Put In	Pulled Out
Surface soil, sand, Gravel, blue shale	none	0	153	10-3/4"	153	None

Describe in detail the manner in which the well was plugged, indicating where the mud fluid was placed and the method or methods used in introducing it into the hole. If cement or other plugs were used, state the character of same and depth placed, from 150 feet to 30 feet for each plug set.

Gunned pits, filled hole with heavy mud from 4963' to 153' - drove plug to 153' with drill pipe, mixed 20 sax cement, spotted on top of plug through drill pipe, filled surface pipe with mud to 30', drove plug to 30', filled hole with cement to top of surface casing.

3-29-52

(If additional description is necessary, use BACK of this sheet)

Correspondence regarding this well should be addressed to Ben F. Brack Oil Company, Inc.
Address 309 Brown Bldg., Wichita 2, Kansas


STATE OF KANSAS, COUNTY OF SEDGWICK, ss.
Leland E. Brack (employee of owner) or (owner or operator) of the above-described well,
being first duly sworn on oath, says: That I have knowledge of the facts, statements, and matters herein contained and the log of the above-described well as filed and that the same are true and correct. So help me God.

(Signature) Leland E. Brack
309 Brown Bldg., Wichita 2, Kansas
(Address)

SUBSCRIBED AND SWORN to before me this 28th day of March, 1952
Gertrude Crit
Notary Public.

My commission expires June 11, 1955

22-2025 2-48-15M

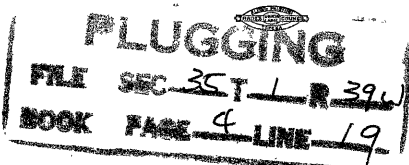

BEN F. BRACK OIL COMPANY, INC.
 309-10 Brown Building
 Wichita 2, Kansas

JUDY #2

NE NE NE

Sec. 35-1S-39W
 Cheyenne County, Kansas
 Commenced: 2-28-52
 Completed: 3-21-52

Total Depth: 4960'
 Elevation: 3122 KB
 3112 Gr

WELL LOG

Soil Clay	0-	115'
Shale & Sand		153
Shale & Shells		1115
Niobrara Shale & Shells		1490
Shale		1580
Chalky Lime		1680
Shale & Chalk		1960
Sand		2090
Sand & Shale		2205
Sandy Shale		2355
Sand		2408
Sand & Shale		2783
Shale & Lime		2855
Red Rock, Shale & Shells		3005
Shale - Red Rock		3079
Chalky Lime		3106
Lime & Shale		3210
Shale & Lime		3322
Lime - Shale		3525
Shale & Lime		3550
Red Bed - Lime		3560
Shale - Lime		3661
Lime - Shale		3706
Shale - Lime		3742
Lime & Shale		3903
Shale		3930
Lime		3997
Lime & Shale		4037
Lime		4145
Shale & Lime		4163
Lime & Shale		4479
Lime		4545
Lime & Shale		4633
Shale & Lime		4670
Lime		4714
Lime & Shale		4896
Lime		4960

FORMATIONS

Niobrara	1086'
Ft. Hays	1551
Codell Sand	1622
Greenhorn	1809
Graneros	1902
"D" Sand	1959
Dakota Sand	2432
Kiowa-Fuson	2507
Cheyenne-Lakota	2550
Morrison	2643
Day Creek	2820
Stone Corral	3074
Ft. Riley	3250
Cherty Lime	3663
Howard	3912
Topeka	3960
Deer Creek	4002
Oread	4084
Heebner	4114
Toronto	4134
Lansing-Kansas	
City	4149
Base of Kansas	
City	4397
Marmaton	4397
Marmaton Zone equals	
Judy #1	4501
Cherokee	4654
Cherty Conglomerate	4832
Mississippi Lime	4854
Mississippi Dolomite	4875

Schlumberger T.D. 4963'

CASING RECORD

10-3/4" 153'

To the best of my knowledge,
 the above is a true and correct
 statement of the depths and
 formations and where found.

PLUGGING
 FILE SEC 35T-1R-39W
 BOOK PAGE 4 LINE 19

WITNESSED: Gertrude Crist

March 25, 1952.

BEN F. BRACK OIL COMPANY, INC.

By Clyton E. Lee