


STATE OF KANSAS
CORPORATION COMMISSION

Give All Information Completely
Make Required Affidavit
Mail or Deliver Report to:
Conservation Division
State Corporation Commission
211 No. Broadway
Wichita, Kansas

15-023-01001-00-00
WELL PLUGGING RECORD

NORTH

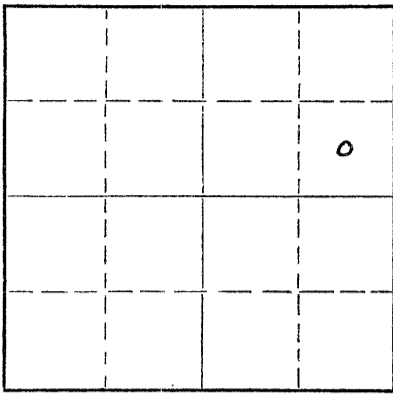

Locate well correctly on above
Section Plat

Cheyenne County. Sec. 33 Twp. 1 Rge. 39 (E) (W)
Location as "NE/CNW/SW" or footage from lines. C SE NE
Lease Owner Kern Drilling Co
Lease Name Galvin Well No. 1
Office Address Box 107 Liberal, Kansas
Character of Well (completed as Oil, Gas or Dry Hole) Dry hole
Date well completed 5-18-60 19
Application for plugging filed By request 5-18-60 19
Application for plugging approved By request 5-18-60 19
Plugging commenced 5-18-60 19
Plugging completed 5-18-60 19
Reason for abandonment of well or producing formation Dry hole

If a producing well is abandoned, date of last production _____ 19
Was permission obtained from the Conservation Division or its agents before plugging was commenced? Yes

Name of Conservation Agent who supervised plugging of this well Mr. Fabricius
Producing formation none Depth to top _____ Bottom _____ Total Depth of Well 4994 Feet
Show depth and thickness of all water, oil and gas formations.

OIL, GAS OR WATER RECORDS

CASING RECORD

FORMATION	CONTENT	FROM	TO	SIZE	PUT IN	PULLED OUT

Describe in detail the manner in which the well was plugged, indicating where the mud fluid was placed and the method or methods used in introducing it into the hole. If cement or other plugs were used, state the character of same and depth placed, from _____ feet to _____ feet for each plug set.

Cement plug of 20 sacks at 400'
Cement plug of 20 sacks at 200'
Cement plug of 10 sacks at 40'

(If additional description is necessary, use BACK of this sheet)
Name of Plugging Contractor Company tools Jelly Reeves Drlg. Co.
Address Cushing, Okla.

STATE OF Kansas, COUNTY OF Seward, ss.

(employee of owner) or (owner or operator) of the above-described well, being first duly sworn on oath, says: That I have knowledge of the facts, statements, and matters herein contained and the log of the above-described well as filed and that the same are true and correct. So help me God.

(Signature) Copeland Landis
Box 107 Liberal, Ks
(Address)

SUBSCRIBED AND SWORN TO before me this 31 day of May, 1960

My commission expires 12-18-63

RECEIVED
STATE CORPORATION COMMISSION

Notary Public.

JUN 1 1960
6-1-60
CONSERVATION DIVISION
Wichita, Kansas