

SIDE ONE

AFFIDAVIT OF COMPLETION FORM

(REV) ACO-1

This form shall be filed in duplicate with the Kansas Corporation Commission, 200 Colorado Derby Building, Wichita, Kansas 67202, within ten days after the completion of the well, regardless of how the well was completed.

Attach separate letter of request if the information is to be held confidential. If confidential, only file one copy. Information on side one will be of public record and side two will then be held confidential.

Circle one: Oil Gas, Dry, SWD, OWWO, Injection. Type and complete ALL sections. Applications must be filed for dual completion, commingling, SWD and injection.

Attach wireline logs (i.e. electrical log, sonic log, gamma ray neutron log, etc.). KCC # (316) 263-3238. (Rules 82-2-105 & 82-2-125)

OPERATOR Sierra Petroleum Co., Inc.

API NO. 15-147-20,343-00-00

ADDRESS P. O. Box 247

COUNTY Phillips

Wichita, Kansas 67201

FIELD Huffstutter

\*\*CONTACT PERSON Jack L. Yinger

PROD. FORMATION Lansing

PHONE 264-8394

LEASE Imm "B"

PURCHASER Permian Corporation

WELL NO. 2

ADDRESS 5800 East Skelly Drive, Suite 301

WELL LOCATION C NE NE NW

Tulsa, Oklahoma 74135

Ft. from Line and

DRILLING Abercrombie Drilling, Inc.

Ft. from Line of

CONTRACTOR

ADDRESS 801 Union Center

the NW/4 SEC. 18 TWP. 2S RGE. 18W


Wichita, Kansas 67202

WELL PLAT

PLUGGING

CONTRACTOR

ADDRESS

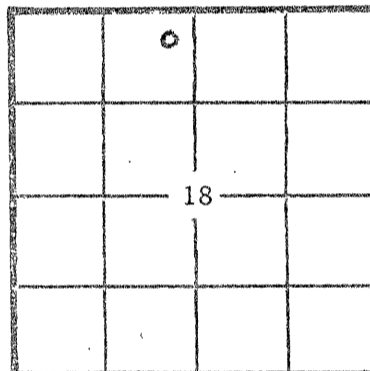

KCC KGS (Office Use)

TOTAL DEPTH 3594' PBD

SPUD DATE 9/2/81 DATE COMPLETED 9/7/81

ELEV: GR 2174 DF KB 2179

DRILLED WITH (ROTARY) (TOOLS)

Amount of surface pipe set and cemented 270' DV Tool Used?

AFFIDAVIT

RECEIVED STATE COMMISSION 12-9-1981

STATE OF Kansas, COUNTY OF Sedgwick SS, I,

Jack L. Yinger, OF LAWFUL AGE, BEING FIRST DULY SWORN UPON HIS OATH,

DEPOSES THAT HE IS Agent (FOR)(OF) Sierra Petroleum Co., Inc.

OPERATOR OF THE Imm "B" LEASE, AND IS DULY AUTHORIZED TO MAKE

THIS AFFIDAVIT FOR AND ON THE BEHALF OF SAID OPERATOR, THAT WELL NO. 2 ON

SAID LEASE HAS BEEN COMPLETED AS OF THE 8th DAY OF December, 19 81, AND THAT

ALL INFORMATION ENTERED HEREIN WITH RESPECT TO SAID WELL IS TRUE AND CORRECT.

FURTHER AFFIANT SAITH NOT.

(S) Jack L. Yinger

SUBSCRIBED AND SWORN BEFORE ME THIS 8th DAY OF December, 19 81.

ALDINE M. JOHNSON NOTARY PUBLIC STATE OF KANSAS My Appointment Expires: 3-19-85

Aldine M. Johnson NOTARY PUBLIC

MY COMMISSION EXPIRES:

\*\*The person who can be reached by phone regarding any questions concerning this information. Within 45 days of completion, a witnessed initial test by the Commission is required if the well produces more than 25 BOPD or is located in a Basic Order Pool.