CARD MUST BE TYPED

State of Kansas

CARD MUST BE SIGNED

NOTICE OF INTENTION TO DRILL

(see rules on reverse side)

Starting Date 9 (month) 3 (day) 85 (year)

API Number 15— 147-20,484-00-00

OPERATOR: License # 6588

Name Woodman-Iannitti Oil Co.

Address 704 Union Center Bldg.

City/State/Zip Wichita, Kansas 67202

Contact Person Peter L. Iannitti

Phone (316) 265-7650

CONTRACTOR: License # 5122

Name Woodman-Iannitti Drlg. Co.

City/State Wichita, Kansas

SW NW NE Sec. 24 Twp. 2 S, Rg. 19 ___ East X West

4290 Ft. from South Line of Section

2310 Ft. from East Line of Section

(Note: Locate well on Section Plat on reverse side)

Nearest lease or unit boundary line 330 feet

County Phillips

Lease Name Bach Well # 3

Ground surface elevation not available yet feet MSL

Domestic well within 330 feet: ___ yes X no

Municipal well within one mile: ___ yes X no

Surface pipe by Alternate: 1 ___ 2 X [redacted]

Depth to bottom of fresh water ~~250~~ ~100

Depth to bottom of usable water Dakota ~1250

Surface pipe planned to be set 217

Projected Total Depth 3516 feet

Formation Arbuckle

Well Drilled For:		Well Class:	Type Equipment:
X Oil	___ SWD	X Infield	X Mud Rotary
___ Gas	___ Inj	___ Pool Ext.	___ Air Rotary
___ OWWO	___ Expl	___ Wildcat	___ Cable

If OWWO: old well info as follows:

Operator

Well Name

Comp Date Old Total Depth

I certify that well will comply with K.S.A. 55-101, et seq., plus eventually plugging hole to KCC specifications. ~~Production casing will be immediately cemented~~

[redacted]

Date 8-21-85 Signature of Operator or Agent ~~Peter L. Iannitti~~ Title Consultant

Peter L. Iannitti

For KCC Use:

Conductor Pipe Required ___ feet; Minimum Surface Pipe Required 200 feet per Alt. 1 2 [redacted]

This Authorization Expires 2-21-86 Approved By PCH 8-21-85

Must be filed with the K.C.C. five (5) days prior to commencing well
This card void if drilling not started within six (6) months of date received by K.C.C.

RECEIVED
STATE CORPORATION COMMISSION

AUG 21 1985

8-21-85

CONSERVATION DIVISION
Wichita, Kansas

A Regular Section of Land
1 Mile = 5,280 Ft.

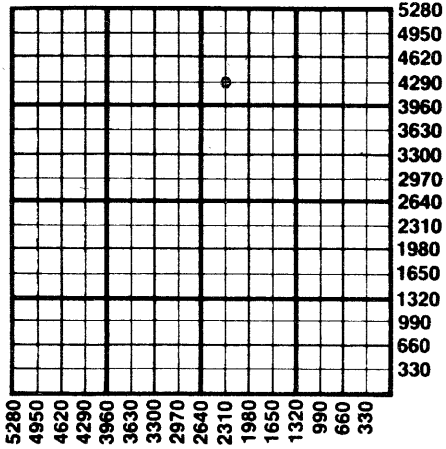

Important procedures to follow:

1. Notify District office before setting surface casing.
2. Set surface casing by circulating cement to the top.
3. File completion forms ACO-1 with K.C.C. within 90 days of well completion, following instructions on ACO-1, side 1, and including copies of wireline logs.
4. Notify District office 48 hours prior to old well workover or re-entry.
5. Prior to filing Intent, prepare a proposed plugging plan in case well is D & A, then obtain approval of plan when calling district office prior to setting surface pipe.
6. Submit plugging report (CP-4) to K.C.C. after plugging is completed.
7. Obtain an approved injection docket number before disposing of salt water.
8. Notify K.C.C. within 10 days when injection commences or terminates.
9. If an alternate 2 completion, cement in the production pipe from below any usable water to surface within 120 days of spud date.

State Corporation Commission of Kansas
Conservation Division
200 Colorado Derby Building
Wichita, Kansas 67202
(316) 263-3238