

CARD MUST BE TYPED

State of Kansas

CARD MUST BE SIGNED

### NOTICE OF INTENTION TO DRILL

(see rules on reverse side)

CORRECTED INTENT\*\*

Starting Date ..... 9 ..... 18 ..... 85  
month day year

API Number 15— 147-20,483 -00-00

OPERATOR: License # ..... 6588 .....  
Name ..... Woodman-Iannitti Oil Co. ....  
Address ..... 704 Union Center Bldg. ....  
City/State/Zip ..... Wichita, Kansas 67202 .....  
Contact Person ..... Peter L. Iannitti .....  
Phone ..... (316) 265-7650 .....

\*\*NW SW NE Sec. 24 Twp. 2 S, Rg. 19  East  
\*3630  West  
\*2310 ..... Ft. from South Line of Section  
..... Ft. from East Line of Section

(Note: Locate well on Section Plat on reverse side)

CONTRACTOR: License # ..... 5122 .....  
Name ..... Woodman-Iannitti Drlg. Co. ....  
City/State ..... Wichita, Kansas 67202 .....

Nearest lease or unit boundary line ..... 330 ..... feet  
County ..... Phillips .....

Well Drilled For: Well Class: Type Equipment:  
 Oil  SWD  Infield  Mud Rotary  
 Gas  Inj  Pool Ext.  Air Rotary  
 OWWO  Expl  Wildcat  Cable

Lease Name ..... Hanke ..... Well # ..... 2 .....  
Ground surface elevation not yet available ..... feet MSL

If OWWO: old well info as follows:  
Operator .....  
Well Name .....  
Comp Date ..... Old Total Depth .....

Domestic well within 330 feet:  yes  no  
Municipal well within one mile:  yes  no  
Surface pipe by Alternate: 1  2   
Depth to bottom of fresh water ..... 100 .....  
Depth to bottom of usable water ..... 1250 .....  
Surface pipe planned to be set ..... 217 .....  
Projected Total Depth ..... 3516 ..... feet  
Formation ..... Arbuckle .....

I certify that well will comply with K.S.A. 55-101, et seq., plus eventually plugging hole to KCC specifications.

\*WAS: NNWSE  
2310 FSL  
2310 FE

Date ..... Signature of Operator or Agent ..... Peter L. Iannitti ..... Title ..... Consultant .....

For KCC Use:  
Conductor Pipe Required ..... feet; Minimum Surface Pipe Required ..... feet per Alt. 1 2  
This Authorization Expires 2-21-86 ..... Approved By RCH 8-23-85 ORIB RCVB 8-21-85 .....


Must be filed with the K.C.C. five (5) days prior to commencing well  
This card void if drilling not started within six (6) months of date received by K.C.C.

RECEIVED  
STATE CORPORATION COMMISSION

Important procedures to follow:

A Regular Section of Land  
1 Mile = 5,280 Ft.

AUG 23 1985  
823-85  
CONSERVATION DIVISION  
Wichita, Kansas

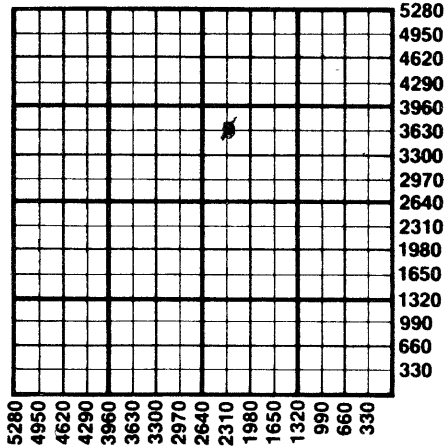

1. Notify District office before setting surface casing.
2. Set surface casing by circulating cement to the top.
3. File completion forms ACO-1 with K.C.C. within 90 days of well completion, following instructions on ACO-1, side 1, and including copies of wireline logs.
4. Notify District office 48 hours prior to old well workover or re-entry.
5. Prior to filing Intent, prepare a proposed plugging plan in case well is D & A, then obtain approval of plan when calling district office prior to setting surface pipe.
6. Submit plugging report (CP-4) to K.C.C. after plugging is completed.
7. Obtain an approved injection docket number before disposing of salt water.
8. Notify K.C.C. within 10 days when injection commences or terminates.
9. If an alternate 2 completion, cement in the production pipe from below any usable water to surface within 120 days of spud date.

State Corporation Commission of Kansas  
Conservation Division  
200 Colorado Derby Building  
Wichita, Kansas 67202  
(316) 263-3238