

STATE OF KANSAS  
STATE CORPORATION COMMISSION  
130 S. Market, Room 2078  
Wichita, KS 67202

RECEIVED  
CORPORATION COMMISSION  
JUN 28 2004  
06-08-04  
CONSERVATION DIVISION  
WICHITA, KS

WELL PLUGGING RECORD  
K.A.R.-62-3-117

API NUMBER 15-129-21120-00-00  
LEASE NAME RUSSELL  
WELL NUMBER 1-1X

TYPE OR PRINT  
NOTICE: Fill out completely  
and return to Cons. Div.  
office within 30 days.

1368 Ft. from S Section Line  
3827 Ft. from E Section Line  
SEC. 1 TWP. 32 RGE. 42 (E) or (W)  
COUNTY MORTON  
Date Well Completed 7/31/1997  
Plugging Commenced 5/16/2004  
Plugging Completed 5/12/2004

LEASE OPERATOR DUKE ENERGY FIELD SERVICES, LP

ADDRESS 6120 S. YALE, SUITE 1100 TULSA, OK

PHONE(S) (918) 492-3331 OPERATORS LICENSE NO. 32782

Character of Well GAS STORAGE  
(Oil, Gas, D&A, SWD, Input, Water Supply Well)

The plugging proposal was approved on 5/3/2004 4-19-04 (date)  
by S. DURRANT (KCC District Agent's Name).

Is ACO-1 filed? YES If not, Is well log attached? \_\_\_\_\_

Producing Formation G2/KEYES Depth to Top 4930/5006 Bottom 4940/5024 D. 5242

Show depth and thickness of all water, oil and gas formations. 5250

OIL, GAS OR WATER RECORDS | CASING RECORD

Formation	Content	From	To	Size	Put in	Pulled out
<u>G2/KEYES</u>	<u>GAS</u>	<u>4930</u>	<u>5022</u>	<u>7"</u>	<u>5242</u>	<u>600 ft</u>
<u>PERMIAN</u>	<u>FRESH WATER</u>	<u>200</u>	<u>400</u>	<u>9 5/8"</u>	<u>1478</u>	<u>0</u>

Describe in detail the manner in which the well was plugged, indicating where the mud fluid was placed and the method or methods used in introducing it into the hole. If cement or other plug were used, state the character of same and depth placed, from \_\_\_ feet to \_\_\_ feet each set.  
SEE ATTACHED

PLUGGED AS PER KCC REGULATIONS

Name of Plugging Contractor EAGLE WELL SERVICE, INC License No. 7407

Address P.O. BOX 1597 LIBERAL, KS 67905-1597

NAME OF PARTY RESPONSIBLE FOR PLUGGING FEES: DUKE ENERGY FIELD SERVICES, LP

STATE OF OKLAHOMA COUNTY OF TULSA, ss.

Paul Brewer (Employee of Operator) or (Operator) o  
above-described well, being first duly sworn on oath, says: That I have knowledge of the facts  
statements, and matters herein contained and the log of the above-described well as filed the  
the same are true and correct, so help me God.


(Signature) Paul Brewer

(Address) 6120 S. Yale Ave, Ste 1100, Tulsa, OK 74133

SUBSCRIBED AND SWORN TO before me this 4<sup>th</sup> day of June, 2004


Sylvia B. Powell  
Notary Public

My Commission Expires: Aug 31, 2007

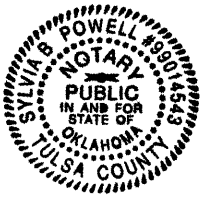

**Duke Energy Field Services**

**Plug and Abandonment Schematic**

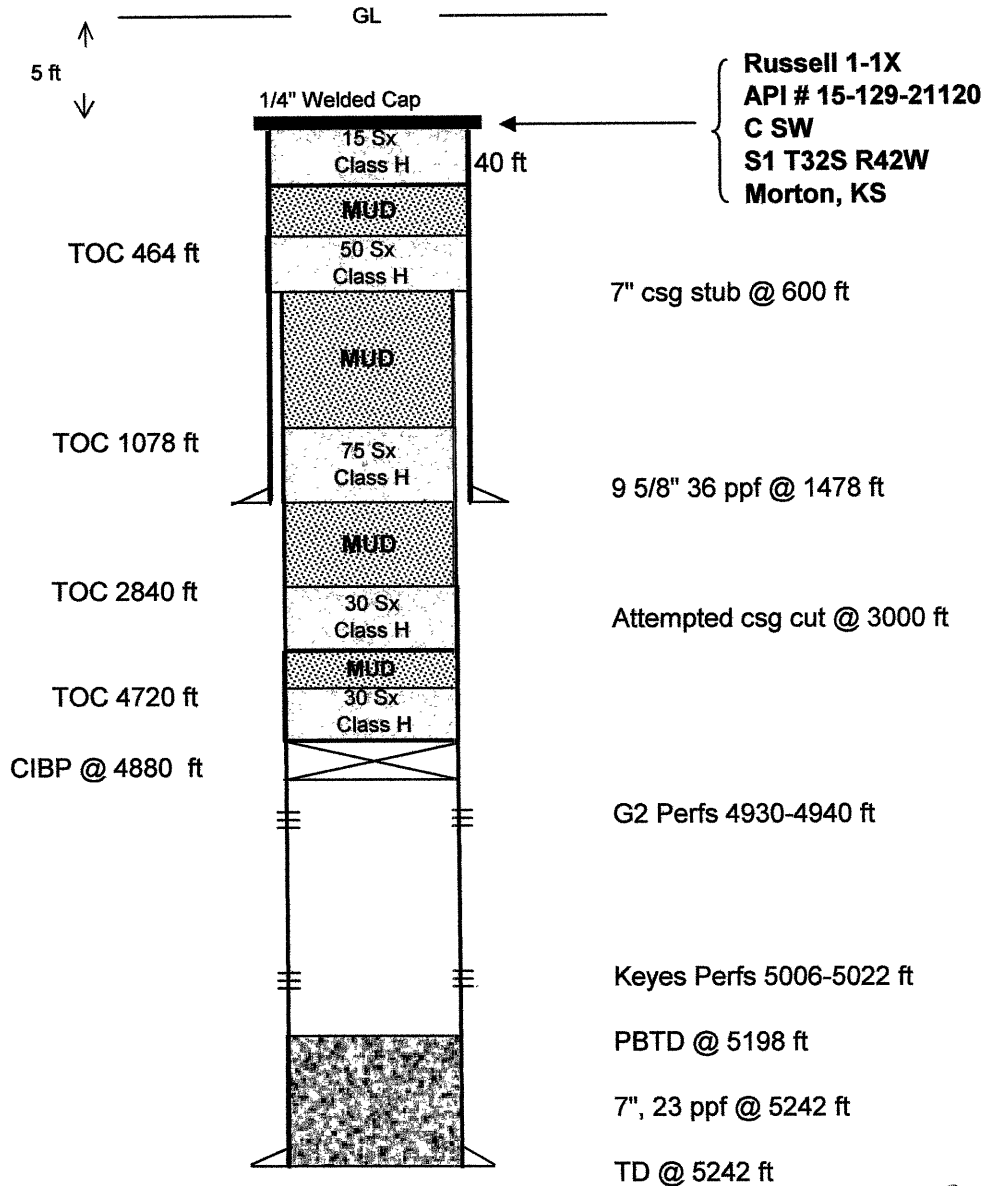

**Plug and Abandonment Details:**

Date Well Completed: March 7, 1992  
 Plugging Commenced: May 10, 2004  
 Plugging Completed: May 12, 2004

RECEIVED  
 KANSAS CORPORATION COMMISSION  
 JUN 08 2004  
 CONSERVATION DIVISION  
 WICHITA, KS