

15-147-00058-00-00

STATE OF KANSAS
STATE CORPORATION COMMISSION

WELL PLUGGING RECORD


Give All Information Completely
Make Required Affidavit
Mail or Deliver Report to:
Conservation Division
State Corporation Commission
800 Bitting Building
Wichita, Kansas

PHILLIPS

County. Sec. 28 Twp. 2 Rge. 18 (E) W (W)

Location as "NE/CNW 1/4 SW 1/4" or footage from lines SE SE NW
Lease Owner Jones, Shelburne & Farmer, Inc.
Lease Name Doman Well No. 1
Office Address Russell, Kansas
Character of Well (completed as Oil, Gas or Dry Hole) Dry Hole
Date well completed 11-28- 1952
Application for plugging filed 11-28- 1952
Application for plugging approved 11-28- 1952
Plugging commenced 11-28- 1952
Plugging completed 11-28- 1952

NORTH

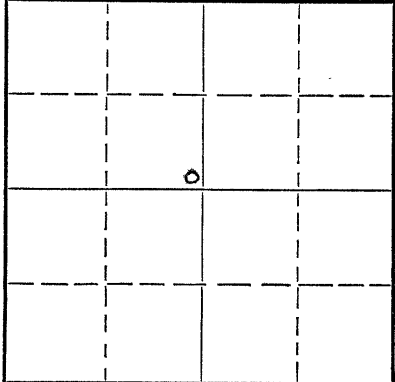

Locate well correctly on above
Section Plat

Reason for abandonment of well or producing formation Dry Hole

If a producing well is abandoned, date of last production 19

Was permission obtained from the Conservation Division or its agents before plugging was commenced? yes

Name of Conservation Agent who supervised plugging of this well Eldon Petty

Producing formation Depth to top Bottom Total Depth of Well 3814 Feet

Show depth and thickness of all water, oil and gas formations.

OIL, GAS OR WATER RECORDS

CASING RECORD

Formation	Content	From	To	Size	Put In	Pulled Out
Surface	Pipe	0	205	8-5/8	205	0

Describe in detail the manner in which the well was plugged, indicating where the mud fluid was placed and the method or methods used in introducing it into the hole. If cement or other plugs were used, state the character of same and depth placed, from feet to feet for each plug set.

Fill hole with mud, set first plug at 190', cemented with 15 sacks of cement. Filled hole to 40', ran second plug, cemented with 10 sacks of cement.

RECEIVED
STATE CORPORATION COMMISSION

DEC 10 1952

CONSERVATION DIVISION
Wichita, Kansas

12-10-52

(If additional description is necessary, use BACK of this sheet)

Name of Plugging Contractor Empire Drilling Company
Address 1121 Union National Bank Building, Wichita 2, Kansas

STATE OF Kansas, COUNTY OF Sedgwick, ss.
I, Dan J. Kornfeld

being first duly sworn on oath, says: That I have knowledge of the facts, statements, and matters herein contained and the log of the above-described well as filed and that the same are true and correct. So help me God.

(Signature) Dan J. Kornfeld
1121 Union Nat'l. Bk. Bldg., Wichita 2, Kans.
(Address)

SUBSCRIBED AND SWORN to before me this 4th day of December, 1952

My commission expires May 5, 1956

Mary Heininger
Notary Public.

PLUGGING
FILE SEC 28 T 2 R 18
BOOK PAGE 62 LINE 30

15-147-00058-00-00

LOG

COMPANY: Jones, Shelburne & Farmer, Inc.
 CONTRACTOR: EMPIRE DRILLING COMPANY
 FARM: Doman #1
 LOCATION: SE SE NW, Sec. 28-2-18 W,
 Phillips County, Kansas
 COMMENCED: 11-17-52
 COMPLETED: 11-28-52

0	to	60	Surface Clay
60	to	223	Shale, Shells and Sand
223	to	1705	Shale and Shells
1705	to	1735	Anhydrite
1735	to	1980	Shale and Shells
1980	to	2305	Shale and Lime
2305	to	2900	Shale and Shells
2900	to	3145	Shale and Lime
3145	to	3276	Lime and Shale
3276	to	3320	Shale and Lime
3320	to	3670	Lime
3670	to	3715	Shale and Lime
3715	to	3770	Lime and Shale
3770	to	3814	Lime
3814			R.T.D.

Set at 206' - 8-5/8" Surface Casing, Cemented with 125 sacks of cement.

ELEVATION: 2065' D.F.

SCHLUMBERGER: 3814'

D&A

C E R T I F I C A T I O N

I, Dan J. Kornfeld, do hereby certify that the above and foregoing is a true and correct copy of the log of the Doman #1 in Section 28, Township 2, Range 18 West, Phillips County, Kansas, as reflected by files of the Empire Drilling Company.

Dan J. Kornfeld
 Dan J. Kornfeld

Subscribed and sworn to before me a Notary Public, within and for Sedgwick County, Kansas, this 4th day of December, 1952.

RECEIVED
 RECORDS COMMISSION
 DEC 10 1952 12-10-52
 RECORDS DIVISION

Mary K. Hummer
 NOTARY PUBLIC

My Commission Expires May 5, 1956

PLUGGING
 FILE SEC 28-2-R-184
 BOOK PAGE 62 LINE 30