


STATE CORPORATION  
 Give All Information  
 Make Required Affidavit  
 Mail or Deliver Report to:  
 Conservation Division  
 State Corporation Commission  
 211 No. Broadway  
 Wichita, Kansas

15-147-00129-00-00  
**WELL PLUGGING RECORD**

NORTH

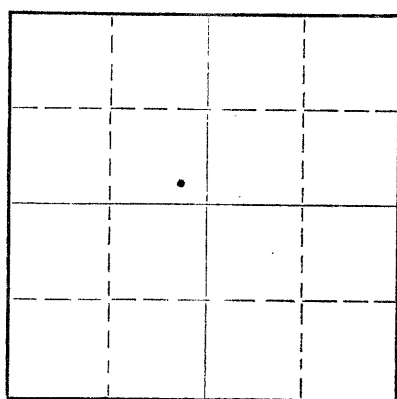

Locate well correctly on above Section Plat

Phillips County. Sec. 24 Twp. 2S Rge. 18 (A) (W)  
 Location as "NE/CNW4SW4" or footage from lines G-SE/4-SE/4-NW/4  
 Lease Owner Amerada Petroleum Corporation  
 Lease Name H.W. Hanke Well No. 1  
 Office Address Box 197, Great Bend, Kansas  
 Character of Well (completed as Oil, Gas or Dry Hole) Dry Hole  
 Date well completed 8-15-1958  
 Application for plugging filed 8-18-1958  
 Application for plugging approved 19  
 Plugging commenced 5:00 PM 8-15-58 19  
 Plugging completed 7:00 PM 8-15-58 19  
 Reason for abandonment of well or producing formation Dry Hole

If a producing well is abandoned, date of last production - 19  
 Was permission obtained from the Conservation Division or its agents before plugging was commenced? Yes

Name of Conservation Agent who supervised plugging of this well Eldon Petty, Hays, Kansas  
 Producing formation \_\_\_\_\_ Depth to top \_\_\_\_\_ Bottom \_\_\_\_\_ Total Depth of Well 3835' Feet  
 Show depth and thickness of all water, oil and gas formations.

**OIL, GAS OR WATER RECORDS**

**CASING RECORD**

FORMATION	CONTENT	FROM	TO	SIZE	PUT IN	PULLED OUT
				8-5/8"	1450'	None

Describe in detail the manner in which the well was plugged, indicating where the mud fluid was placed and the method or methods used in introducing it into the hole. If cement or other plugs were used, state the character of same and depth placed, from \_\_\_\_\_ feet to \_\_\_\_\_ feet for each plug set.

Spotted Cement plug @ 500' w/20 Sax Cement & filled w/heavy mud to 180'.  
Spotted Cement plug @ 180' w/15 Sax Cement & filled w/Heavy mud to 40'.  
Set Halliburton plug @ 40' with 1/2 Sax of cottonseeds hulls & filled with 10 sax cement to bottom of callar.  
Finished @ 7:00 PM 8-15-58.

(If additional description is necessary, use BACK of this sheet)

Name of Plugging Contractor Peel Brothers Inc.  
 Address Box 88 - Hoisington, Kansas

STATE OF Kansas, COUNTY OF Barton, ss. Clifford E. Richardson

(employee of owner) ~~not a lawyer or operator~~ of the above-described well, being first duly sworn on oath, says: That I have knowledge of the facts, statements, and matters herein contained and the log of the above-described well as filed and that the same are true and correct. So help me God.

(Signature) Clifford E. Richardson  
Box 197 - Great Bend, Kansas (Address)

SUBSCRIBED AND SWORN TO before me this 18<sup>th</sup> day of August, 1958

My commission expires July 29, 1961

**RECEIVED**  
 STATE CORPORATION COMMISSION Notary Public.

AUG 20 1958

**PLUGGING**  
 FILE SEC. 24 T. 2 R. 18W  
 BOOK PAGE 124 LINE 15

CONSERVATION DIVISION  
 Wichita, Kansas

8-20-58