


Give All Information Completely
 Make Required Affidavit
 Mail or Deliver Report to:
 Conservation Division
 State Corporation Commission
 800 Biting Building
 Wichita, Kansas

OR
FORMATION PLUGGING RECORD

Strike out upper line
 when reporting plug-
 ging off formations.

NORTH

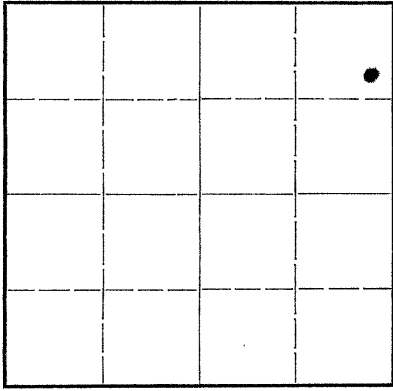

Locate well correctly on above
 Section Plat

Phillips County. Sec. 22 Twp. 2 S Rge. (E) 18 (W)
 Location as "NE $\frac{1}{4}$ NW $\frac{1}{4}$ SW $\frac{1}{4}$ " or footage from lines SE $\frac{1}{4}$ NE $\frac{1}{4}$ NE $\frac{1}{4}$
 Lease Owner The Superior Oil Company
 Lease Name GOOD Well No. 82-22
 Office Address Box #690, Chickasha, Oklahoma
 Character of Well (completed as Oil, Gas or Dry Hole) Dry Hole
 Date well completed September 28 19 50
 Application for plugging filed 19
 Application for plugging approved September 26 19 50
 Plugging commenced September 27 19 50
 Plugging completed September 28 19 50
 Reason for abandonment of well or producing formation Dry Hole

If a producing well is abandoned, date of last production 19
 Was permission obtained from the Conservation Division or its agents before plugging was com-
 menced? Yes

Name of Conservation Agent who supervised plugging of this well
 Producing formation Depth to top Bottom Total Depth of Well Feet
 Show depth and thickness of all water, oil and gas formations.

OIL, GAS OR WATER RECORDS

CASING RECORD

Formation	Content	From	To	Size	Put In	Pulled Out
				13 3/8	207	None

Describe in detail the manner in which the well was plugged, indicating where the mud fluid was placed and the method or methods used in introducing it into the hold. If cement or other plugs were used, state the character of same and depth placed, from feet to feet for each plug set.
 50-sack plug @ 207' and 25-sack plug @ surface. Welded cap.

RECEIVED
 STATE CORPORATION COMMISSION
 OCT 5 - 1950
 CONSERVATION DIVISION
 Wichita, Kansas

(If additional description is necessary, use BACK of this sheet)
 Correspondence regarding this well should be addressed to The Superior Oil Company 10-5-50
 Address Box #690, Chickasha, Oklahoma

STATE OF OKLAHOMA, COUNTY OF GRADY, ss.
 Floyd L. Martin, Jr. (employee of owner) or common operator of the above-described well,
 being first duly sworn on oath, says: That I have knowledge of the facts, statements, and matters herein contained and the log of the above-described well as filed and that the same are true and correct. So help me God.

(Signature) *Floyd L. Martin, Jr.*
 FLOYD L. MARTIN, JR.
 Box #690, Chickasha, Oklahoma (Address)

SUBSCRIBED AND SWORN to before me this 4th day of October 19 50
L. R. Stephens
 L. R. STEPHENS Notary Public.

My commission expires July 15, 1953

PLUGGING
 FILE SEC-27-T-V-R (16)
 BOOK PAGE 31 LINE 28

15-147-30171-00-00

W E L L L O G

SUPERIOR 82-22 GOOD
SE NE NE 22-2S-18W
Phillips, Co., Kansas

<u>From</u>	<u>To</u>	<u>Formation</u>
0	9	Sub-structure
9	68	Sandy soil
68	80	Sand
80	103	Shale
103	135	Sand
135	535	Shale and shells
535	800	Sand
800	1265	Shale and shells
1265	1305	Sand
1305	1365	Shale and sand
1365	1520	Sandy shale
1520	1810	Red Shale
1810	1948	Anhydrite, shale, and lime
1948	3225	Shale and lime
3125	3208	Lime
3208	3220	Shale
3220	3330	Lime
3330	3348	Lime and shale
3348	3368	Lime
3368	3377	Shale
3377	3506	Lime
3506	3573	Lime and shale
3573	3587	Shale
3587	3605	Broken Lime
3605	3705	Shale
3705	3730	Shale and lime
3730	3746	Shale
3746	3787	CORING
	T.D.	

Floyd L. Martin, Jr.
 FLOYD L. MARTIN, JR. Engr
 The Superior Oil Company
 Box #690
 Chickasha, Oklahoma

RECEIVED
 CORPORATION COMMISSION
 OCT 5 1950
 DIVISION
 10-5-50

PLUGGING
 FILE SEC 22 T 2 R 18W
 BOOK PAGE 31 LINE 28