

15-183-00006-00-00

STATE OF KANSAS  
STATE CORPORATION COMMISSION

WELL PLUGGING RECORD

OR


FORMATION PLUGGING RECORD

Strike out upper line  
when reporting plug-  
ging off formations.

Give All Information Completely  
Make Required Affidavit  
Mail or Deliver Report to:  
Conservation Division  
State Corporation Commission  
800 Bitting Building  
Wichita, Kansas

Smith County. Sec. 26 Twp. 2S Rge. (E) 15 (W)  
Location as "NE1/4NW1/4SW1/4" or footage from lines SW SW SW  
Lease Owner Earl F. Wakefield, et al  
Lease Name Stockton Well No. 1  
Office Address 307 Union National Bank Bldg., Wichita, Kansas  
Character of Well (completed as Oil, Gas or Dry Hole) Dry Hole  
Date well completed May 7 19 52  
Application for plugging filed May 7 19 52  
Application for plugging approved May 7 19 52  
Plugging commenced May 7 19 52  
Plugging completed May 7 19 52  
Reason for abandonment of well or producing formation

NORTH

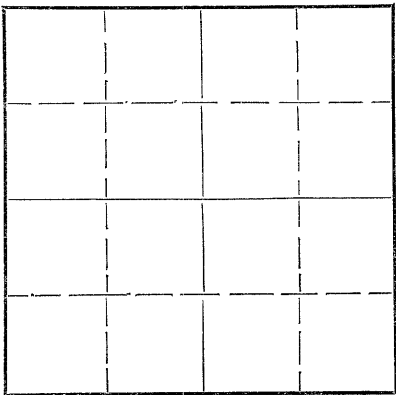

Locate well correctly on above  
Section Plat

Name of Conservation Agent who supervised plugging of this well C. D. Stough, Box 207, Great Bend, Kansas  
Producing formation Depth to top Bottom Total Depth of Well 3900 Feet  
Show depth and thickness of all water, oil and gas formations.

OIL, GAS OR WATER RECORDS

CASING RECORD

Formation	Content	From	To	Size	Put In	Pulled Out
				8 5/8	109	None

Describe in detail the manner in which the well was plugged, indicating where the mud fluid was placed and the method or methods used in introducing it into the hole. If cement or other plugs were used, state the character of same and depth placed, from \_\_\_\_\_ feet to \_\_\_\_\_ feet for each plug set.

Filled with heavy mud from 3900' to 115'. Put plug at 115'.  
Cemented on top with 15 sacks cement. Filled with heavy mud  
to 30'. Set plug at 30', 10 sacks cement on top of plug to  
top of surface.

FILED  
STATE CORP.

CONSERVATION

(If additional description is necessary, use BACK of this sheet)

Correspondence regarding this well should be addressed to Earl F. Wakefield  
Address 307 Union National Bank Building, Wichita, Kansas

9-16-52

STATE OF Kansas, COUNTY OF Sedgwick, ss.

Earl F. Wakefield (employee of owner) or (owner or operator) of the above-described well,  
being first duly sworn on oath, says: That I have knowledge of the facts, statements, and matters herein contained and the log of the above-  
described well as filed and that the same are true and correct. So help me God.

(Signature)

Earl F. Wakefield  
307 Union Natl. Bk. Bldg., Wichita, Ks.  
(Address)

SUBSCRIBED AND SWORN to before me this 13th day of May 19 52

Signature of Notary Public: E. Jeanne Gaffney  
Notary Public

My commission expires 12-23-54

22-2625 2-48-15M

PLUGGING  
FILE SEC 26 T 2 R 15W  
BOOK PAGE 14 LINE 16

Stockton #1  
Owner: Earl F. Wakefield, et al  
Contractor: Earl F. Wakefield  
Comm: 4-27-52 Comp: 5-7-52

SW SW SW 26-2S-15W  
Smith County, Kansas  
Casing: 109' of 8 5/8"

Elevation 1852 D.F.

Sand & Lime Shells	50
Blue Shale	115
Shale & Shells	926
Shale & Red Bed	1470
Shale & Shells	1645
Anhydrite	1790
Shale & Lime	2021
Shale	2080
Shale & Lime	3282
Lime	3437
Lime & Shale	3506
Lime	3545
Shale & Lime	3665
Lime & Chert	3700
Lime	3790
Lime & Shale	3849
Lime	3900
Total Depth	3900

STATE OF KANSAS )  
                          ) SS  
COUNTY OF SEDGWICK )

I hereby certify that the above is a true and correct copy of the log on the Stockton #1 well located SW SW SW 26-2S-15W, Smith County, Kansas.

Earl F. Wakefield

Subscribed and sworn to before me this 14th day of May, 1952.

E. Jeannet Gafney

My Commission Expires: 12-23-54

RECEIVED  
STATE CORPORATION  
MAY 16 1952  
CONSERVATION DIVISION  
Wichita, Kansas

5-16-52

PLUGGING  
FILE 26-2-15W  
BOOK PAGE 14 LINE 16