

15-157-00001-00-00

STATE OF KANSAS  
STATE CORPORATION COMMISSION

WELL PLUGGING RECORD


OR

FORMATION PLUGGING RECORD

Strike out upper line  
when reporting plug-  
ging off formations.

Give All Information Completely  
Make Required Affidavit  
Mail or Deliver Report to:  
Conservation Division  
State Corporation Commission  
800 Biting Building  
Wichita, Kansas

NORTH

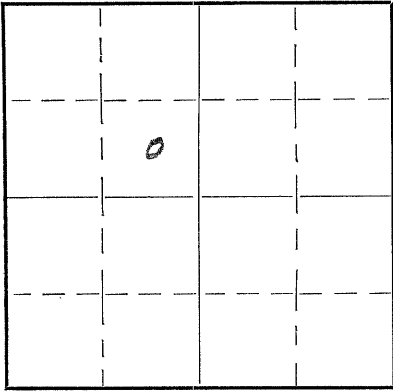

Locate well correctly on above  
Section Plat

REPUBLIC County. Sec. 30 Twp. 2 Rge. (E) 1 (W) 1  
Location as "NE 1/4 NW 1/4 SW 1/4" or footage from lines NE 1/4 OF NW 1/4  
Lease Owner WILCOX OIL & GAS CO.  
Lease Name HARMON Well No. 1  
Office Address Julia Okla.  
Character of Well (Completed as Oil, Gas or Dry Hole) DRY HOLE  
Date, well completed 1-11 1941  
Application for plugging filed 1-11 1941  
Application for plugging approved 1-11 1941  
Plugging Commenced 1-11 1941  
Plugging Completed 1-11 1941  
Reason for abandonment of well or producing formation DRY HOLE

If a producing well is abandoned, date of last production L 193  
Was permission obtained from the Conservation Division or its agents before plugging was com-  
menced? YES

Name of Conservation Agent who supervised plugging of this well RUEL DURKEE  
Producing formation NONE Depth to top L Bottom L Total Depth of Well 35-65 Feet.  
Show depth and thickness of all water, oil and gas formations.

OIL, GAS OR WATER RECORDS

CASING RECORD

Formation	Content	From	To	Size	Put In	Pulled Out
				15 1/2"	4 1/2"	

Describe in detail the manner in which the well was plugged, indicating where the mud fluid was placed and the method or methods used in introducing it into the hole. If cement or other plugs were used, state the character of same and depth placed, from 300 feet to 270 feet for each plug set.

HOLE FILLED WITH HEAVY MUD TO 300 FT OF TOP HOLE BRISED CEMENTED WITH 20 BAGS CEMENT  
HOLE FILLED WITH HEAVY MUD TO 10 FT. OF BOTTOM OF CELLOR HOLE BRISED CEMENTED WITH 10 BAGS CEMENT

MUD & CEMENT PUMPED IN HOLE


30 2 1W  
127 2

(If additional description is necessary, use BACK of this sheet)

Correspondence regarding this well should be addressed to WILCOX OIL & GAS CO.  
Address Julia OKLA.

STATE OF \_\_\_\_\_, COUNTY OF \_\_\_\_\_, SS.  
\_\_\_\_\_ (employee of owner) or (operator) of the above-described well,  
being first duly sworn on oath, says: That I have knowledge of the facts, statements, and matters herein contained and the log of the above described well as filed and that the same are true and correct. So help me God.

(Signature) C. R. Smith  
(Address) \_\_\_\_\_

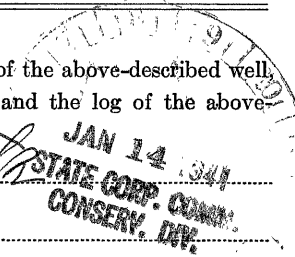

SUBSCRIBED AND SWORN to before me this 13 day of Jan, 1941  
My commission expires Mar 2-1947  
Notary Public.

1-14-1941