

15-147-00780-00-01

STATE OF KANSAS
STATE CORPORATION COMMISSION


Form CP-4

WELL PLUGGING RECORD

Give All Information Completely
Make Required Affidavit
Mail or Deliver Report to:
Conservation Division
State Corporation Commission
212 No. Market
Wichita, Kansas 67202

Phillips County, Sec. 5 Twp. 2 Rge. 18 (E) (W)
Location as "NE/CNWxSWx" or footage from lines NE SE SW

Lease Owner PMT
Lease Name Reese B Well No. 7
Office Address 400 N Woodlawn Wichita Kansas
Character of Well (completed as Oil, Gas or Dry Hole) Oil-Converted to Injection
Date well completed April 19 19 51
Application for plugging filed Jan 4 19 78
Application for plugging approved Jan 9 19 78
Plugging commenced March 16 19 78
Plugging completed March 16 19 78
Reason for abandonment of well or producing formation _____

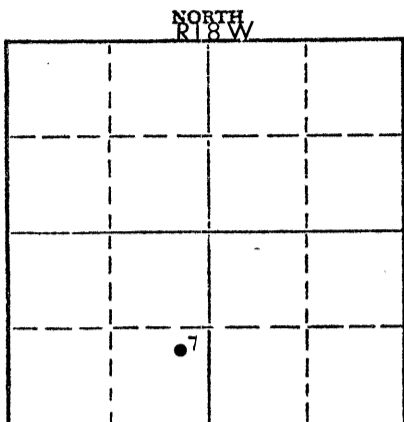

T
2
S

Locate well correctly on above
Section Plat

If a producing well is abandoned, date of last production _____ 19____
Was permission obtained from the Conservation Division or its agents before plugging was commenced? yes

Name of Conservation Agent who supervised plugging of this well Leo Massey
Producing formation KC Depth to top _____ Bottom _____ Total Depth of Well 3469 Feet
Show depth and thickness of all water, oil and gas formations.

OIL, GAS OR WATER RECORDS

CASING RECORD

FORMATION	CONTENT	FROM	TO	SIZE	PUT IN	PULLED OUT
				8 5/8	181	0
				5 1/2	3468	912'

Describe in detail the manner in which the well was plugged, indicating where the mud fluid was placed and the method or methods used in introducing it into the hole. If cement or other plugs were used, state the character of same and depth placed, from _____ feet to _____ feet for each plug set.

Plug back w sand to 3350' Dumped 4 sacks cement w bailing.

Pumped 25 sacks gel-1 sack Hulls and plug followed by 120 sacks 60-40 poz.
Cement from 360' to surface

RECEIVED
STATE CORPORATION COMMISSION
APR 04 1978
CONSERVATION DIVISION
Wichita, Kansas

(If additional description is necessary, use BACK of this sheet)
Name of Plugging Contractor Petroleum Management Inc.
Address 400 N. Woodlawn Wichita, Kansas

STATE OF KANSAS, COUNTY OF SEDGWICK, ss.

(employee of owner) or (owner or operator) of the above-described well, being first duly sworn on oath, says: That I have knowledge of the facts, statements, and matters herein contained and the log of the above-described well as filed and that the same are true and correct. So help me God.

(Signature) Dale Silcott
400 N. Woodlawn, Suite 201, Wichita, Ks. 67208
(Address)

SUBSCRIBED AND SWORN TO before me this 30th day of March, 19 78

My commission expires 3/1/81



Bonnie Brown
Bonnie Brown
Notary Public.