

15-147-20431-00-00


STATE OF KANSAS
STATE CORPORATION COMMISSION
200 Colorado Derby Bldg.
Wichita, Kansas 67202

Form CP-4
Rev. 12-15-80

WELL PLUGGING RECORD

Give All Information Completely
Make Required Affidavit

COUNTY Phillips SEC. 11 TWP. 2S RGE. 19W E/W
Location as in quarters or footage from lines:
200' N of C SW/4 SW/4

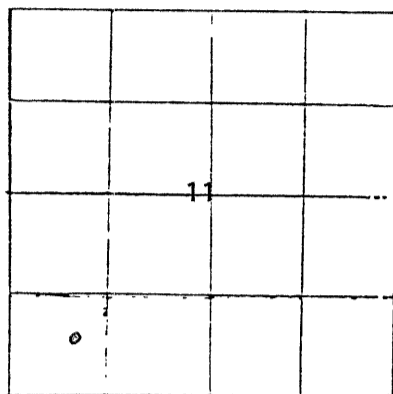

Locate Well
correctly on above
Section Platt.

Lease Owner Credo Petroleum Corporation
Lease Name Elm Well No. 1
Office Address 1905 Sherman St., Suite 700, Denver, Colorado 80203
Character of Well (Completed as Oil, Gas or Dry Hole): Dry Hole
Date Well Completed December 5, 1983
Application for plugging filed December 5, 1983
Plugging commenced December 5, 1983
Plugging completed December 5, 1983
Reason for abandonment of well or producing formation D & A

Was permission obtained from the Conservation Division or it's
Agent's before plugging was commenced? _____

Name of Conservation Agent who supervised plugging of this well Dale Balthazor

Producing formation _____ Depth to top _____ bottom _____ T.D. 3,627'

Show depth and thickness of all water, oil and gas formations.

OIL, GAS OR WATER RECORDS

Casing Records

Formation	Content	From	To	Size	Put in	Pulled Out
				8 5/8"	209.55'	-0-

Describe in detail the manner in which the well was plugged, indicating where the mud
fluid was placed and the method or methods used in introducing it into the hold. If cement
or other plugs were used, state the character of same and depth placed, from _____ feet
to _____ feet for each plug set.

- 1st Plug @ 1810' w/25 sx cement
- 2nd Plug @ 1235' w/100 sx cement
- 3rd Plug @ 250' w/40 sx cement
- Bridge Plug @ 40' w/10 sx cement
- 10 sx cement in rathole
- 50/50 Pozmix, 2% Gel, 3% C.C., 2sx Floseal

(If additional description is necessary, use BACK of this sheet)

Name of Plugging Contractor Allied Cementing Co., Inc.

STATE OF Colorado COUNTY OF Denver, ss.

James T. Huffman * (~~employee of owner~~) or (~~owner or operator~~) of the
above-described well, being first duly sworn on oath, says: That I have knowledge of the
facts, statements, and matters herein contained and the log of the above-described well as
filed and that the same are true and correct. So help me God.

*C.E.O. of CREDO
Petroleum Corporation

(Signature) James T. Huffman
James T. Huffman, C.E.O.

(Address)
1905 Sherman Street, Suite 700
Denver, CO 80203

SUBSCRIBED AND SWORN me this 20th day of January, 1984.

RECEIVED
STATE CORPORATION COMMISSION
JAN 23 1984
CONSERVATION DIVISION
Wichita, Kansas
1-23-84

Commission expires: 4/25/87

Phyllis Wischer Notary Public.
1905 Sherman Street, Suite 700
Denver, CO 80203