


15-147-00141-00-00

STATE OF KANSAS
STATE CORPORATION COMMISSION

WELL PLUGGING RECORD

Give All Information Completely
Make Required Affidavit
Mail or Deliver Report to:
Conservation Division
State Corporation Commission
211 No. Broadway
Wichita, Kansas

Phillips County. Sec. I Twp. 2 Rge. 19 (E) (W)
Location as "NE/CNW/SW" or footage from lines C - NE - SW
Lease Owner Don H. Peaker
Lease Name Vandyke Well No. I
Office Address P.O. Box 1595, Pueblo, Colorado
Character of Well (completed as Oil, Gas or Dry Hole) Oil Well
Date well completed July 4, 19 59
Application for plugging filed May 9, 19 62
Application for plugging approved May 10, 19 62
Plugging commenced May 17 19 62
Plugging completed May 26 19 62
Reason for abandonment of well or producing formation
Non Commercial oil well
If a producing well is abandoned, date of last production May 8th 19 62
Was permission obtained from the Conservation Division or its agents before plugging was commenced? Yes

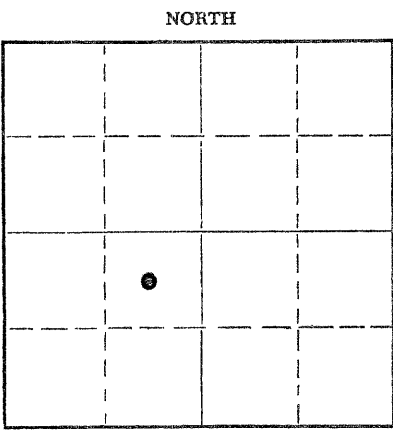

Locate well correctly on above Section Plat

Name of Conservation Agent who supervised plugging of this well Elden Petty
Producing formation Lansing-Kansas City lm. Depth to top 3428 Bottom 3654 Total Depth of Well 3680 Feet
Show depth and thickness of all water, oil and gas formations.

OIL, GAS OR WATER RECORDS

CASING RECORD

FORMATION	CONTENT	FROM	TO	SIZE	PUT IN	PULLED OUT
Lansing-Kansas City lm.	oil	3461	3467	8 5/8"	212'	0'
"	"	3477	3481	4 1/2"	3680'	1591'
"	"	3486	3490			
"	"	3490	3500			
"	"	3505	3508			
"	"	3574	3582			

Describe in detail the manner in which the well was plugged, indicating where the mud fluid was placed and the method or methods used in introducing it into the hole. If cement or other plugs were used, state the character of same and depth placed, from 3680 feet to surface feet for each plug set.

Well had been plugged back to 3648, top perforations at 3477, Sanded up to 3470, Dump 4 sacks of cement with dump bailer. Pipe shot off at 1591, pulled up to 550' Circulated with mud, 20 sacks of cement pump down to 550' pipe pulled up to 180' 20 sacks of cement pump to 180'. Pulled pipe from hole, 10 sacks of cement put on top. Well completed

RECEIVED
STATE CORPORATION COMMISSION
JUN 12 1962
CONSERVATION DIVISION
Wichita, Kansas

(If additional description is necessary, use BACK of this sheet)
Name of Plugging Contractor Barnes & Sons Pipe Pulling Co. 6-12-62
Address Russell, Kansas

STATE OF Colorado COUNTY OF Pueblo, ss.
Don H. Peaker (employee of owner) or (owner or operator) of the above-described well, being first duly sworn on oath, says: That I have knowledge of the facts, statements, and matters herein contained and the log of the above-described well as filed and that the same are true and correct. So help me God.

(Signature) Don H. Peaker
Don H. Peaker
P.O. Box 1595, Pueblo, Colorado
(Address)

SUBSCRIBED AND SWORN TO before me this 9th day of June, 19 62

My Commission Expires Oct. 14, 1965

My commission expires _____ Notary Public.



WELL LOG 15-147-00141-00-00

COMPANY **Don H. Peaker**

SEC. 1 T. 2S R. 19W

FARM **Van Dyke**

NO. 1

LOC. **C/NE 1/4 SW 1/4**

TOTAL DEPTH **3680'**

COUNTY **Phillips**
KANSAS


COMM. **6-23-59**

COMP. **7-4-59**

SHOT OR TREATED

CONTRACTOR **Lewis Drilling Company**

ISSUED

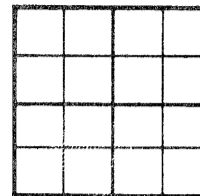

CASING

20	10	
15		x 8 5/8" - 212'
12	6	
13		x 4 1/2" - 3680'

ELEVATION

PRODUCTION

FIGURES INDICATE BOTTOM OF FORMATIONS

0 -	213	Shale & Sand
213 -	1325	Shale
1325 -	1400	Shale & Shells
1400 -	1520	Sand & Shale
1520 -	1570	Shale & Shells
1570 -	1820	Shale
1820 -	1850	Anhydrite
1850 -	2225	Shale & Shells
2225 -	3250	Shale & Lime
3250 -	3680	Lime
3680 -		Total Depth

Geologic Tops

Heebner	3383'
Toronto	3410'
Lansing K C	3425'
Base K C	3646'

6-12-62

State of Kansas)
County of Sedgwick) SS:

I, William J. Duckett of the Lewis Drilling Company upon oath state that the above and foregoing is a true and correct copy of the log of the Van Dyke #1 well.

William J. Duckett

Subscribed and sworn to before me this 8th day of July 19 59

My Commission Expires: August 20, 1960

A. R. Derrington
NOTARY PUBLIC
(A. R. Derrington)