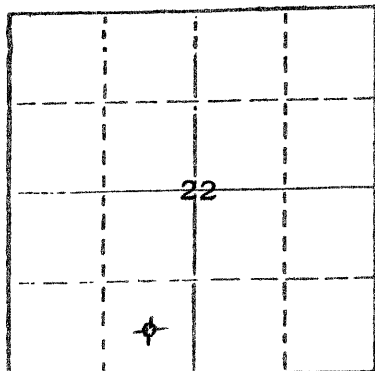


STATE OF KANSAS
STATE CORPORATION COMMISSION

WELL PLUGGING RECORD

Give All Information Completely
Make Required Affidavit
Mail or Deliver Report to
Conservation Division
State Corporation Comm.
245 North Water
Wichita, KS 67202

Locate well correctly on above
Section Plat

Norton County. Sec. 22 Twp. 2S Rge. 23W
Location as "NE/CNW $\frac{1}{4}$ SW $\frac{1}{4}$ " or footage from lines
C SE SW

Lease Owner Hummon Corporation
Lease Name Wallack Well No. 1
Office Address 400 One Main Place, Wichita, Ks. 67202
Character of Well (Completed as Oil, Gas or Dry Hole) Dry Hole

Date Well completed October 17, 1979
Application for plugging filed October 17, 1979
Application for plugging approved October 17, 1979
Plugging commenced October 17, 1979
Plugging completed October 17, 1979
Reason for abandonment of well or producing formation

Dry Hole

If a producing well is abandoned, date of last production 19

Was permission obtained from the Conservation Division or
its agents before plugging was commenced? Yes

Name of Conservation Agent who supervised plugging of this well Gil Balthazor
Producing formation _____ Depth to top _____ Bottom _____ Total Depth of Well 3720
Show depth and thickness of all water, oil and gas formations.

OIL, GAS OR WATER RECORDS

CASING RECORD

FORMATION	CONTENT	FROM	TO	SIZE	PUT IN	PULLED OUT
		0'	256'	8-5/8"	250.50'	None

Describe in detail the manner in which the well was plugged, indicating where the mud fluid was placed and the method or methods used in introducing it into the hold. If cement or other plugs were used, state the character of same and depth placed, from _____ feet to _____ feet for each plug set.

Plugged with 70 sacks cement at 1000',
20 sacks cement at 240', 10 sacks cement
and plug at 40'. (50/50 Pozmix Cement,
6% Gel).

RECEIVED
STATE CORPORATION COMMISSION

(If additional description is necessary, use BACK of this sheet)

Name of Plugging Contractor Allied Cementing Co.

STATE OF KANSAS COUNTY OF SEDGWICK, ss. 11-9-79
John D. Knightley Agent (employee of owner) or (owner or operator)
of the above-described well, being first duly sworn on oath, says: That I have knowledge of
the facts, statements, and matters herein contained and the log of the above-described well
as filed and that the same are true and correct. So help me God.

(Signature)

221 S. Broadway, Wichita, Ks. 67202
(Address)

SUBSCRIBED AND SWORN TO before me this 7th day of November, 19 79

My commission expires March 12, 1983

Stella J. Lipp Notary Public.



15-137-20152-00-00

Hummon Corporation
400 One Main Place
Wichita, Kansas 67202

Wallack #1
C SE SW Sec. 22-2S-23W
Norton County, Kansas

Contractor: D. R. Lauck Oil Company, Inc.
221 S. Broadway, Suite 400
Wichita, Kansas 67202

Commenced: October 11, 1979
Completed: October 17, 1979

Drillers Log

Shale	1944
Anhydrite	1975
Shale & Shells	3020
Shale & Lime	3405
Lime	3440
Lime & Shale	3560
Lime	3560
Lime & Shale	3640
Lime	3720 RTD

RECEIVED
STATE CORPORATION COMMISSION

NOV 09 1979

CONSERVATION DIVISION
Wichita, Kansas

11-9-79