


15-137-20083-00-00

STATE OF KANSAS
STATE CORPORATION COMMISSION

Form CP-4

Give All Information Completely
Make Required Affidavit
Mail or Deliver Report to:
Conservation Division
State Corporation Commission
P. O. Box 17027
Wichita, Kansas 67217
NORTH

WELL PLUGGING RECORD

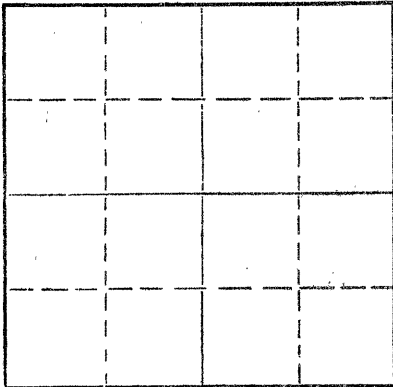

Locate well correctly on above
Section Plat

Norton County, Sec. 25 Twp. 2S Rge. 23W (E) (W) X
Location as "NE/CNW%SW%" or footage from lines NE NW SW
Lease Owner Donald L. Snyder
Lease Name Green Well No. 1-25
Office Address 2701 NW 39th, Oklahoma City, Oklahoma 73112
Character of Well (completed as Oil, Gas or Dry Hole) D&A
Date well completed October 8 1972
Application for plugging filed October 8 1972
Application for plugging approved October 8 1972
Plugging commenced October 8 1972
Plugging completed October 8 1972
Reason for abandonment of well or producing formation D&A
If a producing well is abandoned, date of last production 19
Was permission obtained from the Conservation Division or its agents before plugging was commenced? Yes

Name of Conservation Agent who supervised plugging of this well W. L. Nichols
Producing formation _____ Depth to top _____ Bottom _____ Total Depth of Well _____ Feet
Show depth and thickness of all water, oil and gas formations.

OIL, GAS OR WATER RECORDS

CASING RECORD

FORMATION	CONTENT	FROM	TO	SIZE	PUT IN	PULLED OUT
				8-5/8"	210.41'	-0-


Describe in detail the manner in which the well was plugged, indicating where the mud fluid was placed and the method or methods used in introducing it into the hole. If cement or other plugs were used, state the character of same and depth placed, from _____ feet to _____ feet for each plug set.

Plugged w/110 cf @ 1075', 30 cf @
220', 1/2 sx hulls, plug @ 40' w/
10 cf by Howcol.

RECEIVED
STATE CORPORATION COMMISSION
OCT 24 1972
CONSERVATION DIVISION
Wichita, Kansas

(If additional description is necessary, use BACK of this sheet)
Name of Plugging Contractor Red Tiger Drilling Company 10-24-72
Address 1720 Wichita Plaza, Wichita, Kansas 67202

STATE OF Kansas, COUNTY OF Sedgwick, ss.
Virginia K. Albert (employee of owner) or (owner or operator) of the above-described well, being first duly sworn on oath, says: That I have knowledge of the facts, statements, and matters herein contained and the log of the above-described well as filed and that the same are true and correct. So help me God.

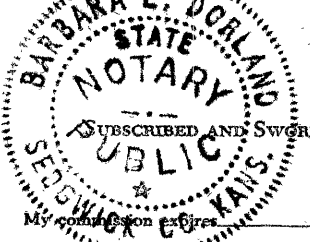

(Signature) Virginia K. Albert
1720 Wichita Plaza, Wichita, Kansas 67202
(Address)

Subscribed and Sworn to before me this 18th day of October, 19 72
Barbara L. Dorland
Notary Public.

My commission expires July 25, 1976.

15-137-20083-00-00

DRILLERS LOG

No. 1-25 Green

CASING RECORD:

8-5/8" @ 210.41'
w/150 sx cement

TOTAL DEPTH: 3,698'

COMPANY: Donald L. Snyder

CONTRACTOR: Red Tiger Drilling Co.

COMMENCED: October 2, 1972

COMPLETED: October 8, 1972

DESCRIPTION:

NE NW SW
25-2S-23W
Norton County,
Kansas

ELEVATION:

<u>FORMATION</u>	<u>FROM</u>	<u>TO</u>	<u>REMARKS</u>
Surface Soil - Clay	0	85	
Shale	85	1050	
Sand	1050	1375	
Shale & Sandstreaks	1375	1490	
Shale & Sand	1490	1905	
Anhydrite	1905	1935	
Shale & Redbed & Shells	1935	2250	
Shale & Shells	2250	2438	
Lime & Shale	2438	3325	
Lime	3325	3369	
Shale	3369	3373	
Lime & Shale	3373	3400	
Lime	3400	3635	
Arbuckle	3635	3682	
Sand	3682	3696	
Granite	3696	3698	

RECEIVED
STATE CORPORATION COMMISSION
OCT 24 1972
CONSERVATION DIVISION
Wichita, Kansas
10-24-72

I certify that this is a true and correct copy of the above log to the best of my knowledge.

RED TIGER DRILLING COMPANY

Virginia K. Albert
Virginia K. Albert

Subscribed and sworn to before me this 18th day of October, 1972.

Barbara L. Dorland
Notary Public

My commission expires:
July 25, 1976

