


15-137-00628-00-00

WELL PLUGGING RECORD

Give All Information Completely  
Make Required Affidavit  
Mail or Deliver Report to:  
Conservation Division  
State Corporation Commission  
211 No. Broadway  
Wichita, Kansas

Norton County, Sec. 25 Twp. 2 Rge. 23 (E) W (W)

Location as "NE/CNW%SW%" or footage from lines SE SE SE  
Lease Owner C-G Drilling Co.  
Lease Name Sanders Well No. 1  
Office Address 107 Rule Building, Wichita, Kansas  
Character of Well (completed as Oil, Gas or Dry Hole) Dry Hole  
Date well completed November 11 1956  
Application for plugging filed November 11 1956  
Application for plugging approved November 11 1956  
Plugging commenced November 12 1956  
Plugging completed November 12 1956  
Reason for abandonment of well or producing formation Too low structurally

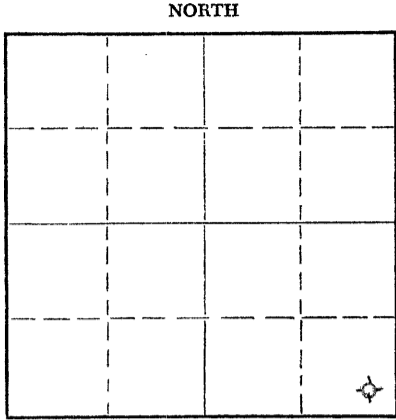

Locate well correctly on above Section Plat

If a producing well is abandoned, date of last production 19  
Was permission obtained from the Conservation Division or its agents before plugging was commenced? Yes

Name of Conservation Agent who supervised plugging of this well Eldon Petty, Hays, Kansas  
Producing formation \_\_\_\_\_ Depth to top \_\_\_\_\_ Bottom \_\_\_\_\_ Total Depth of Well 3632 Feet  
Show depth and thickness of all water, oil and gas formations.

OIL, GAS OR WATER RECORDS

CASING RECORD

| FORMATION | CONTENT | FROM | TO | SIZE   | PUT IN | PULLED OUT |
|-----------|---------|------|----|--------|--------|------------|
|           |         |      |    | 8-5/8" | 308'   | none       |
|           |         |      |    |        |        |            |
|           |         |      |    |        |        |            |
Describe in detail the manner in which the well was plugged, indicating where the mud fluid was placed and the method or methods used in introducing it into the hole. If cement or other plugs were used, state the character of same and depth placed, from \_\_\_\_\_ feet to \_\_\_\_\_ feet for each plug set.

Filled with heavy mud to 300'.  
Set plug. Put in 1/2 sack of  
Hulls and 15 sacks of Cement.  
Filled with heavy mud up to  
40'. Filled to top with 1/2  
Sack of Hulls and 10 sacks of  
Cement.

(If additional description is necessary, use BACK of this sheet)

Name of Plugging Contractor C-G Drilling Co.  
Address 107 Rule Bldg., Wichita, Kansas

STATE OF KANSAS, COUNTY OF SEDGWICK, ss.  
G. F. Galloway (employee of owner) or (owner or operator) of the above-described well, being first duly sworn on oath, says: That I have knowledge of the facts, statements, and matters herein contained and the log of the above-described well as filed and that the same are true and correct. So help me God.

(Signature) G. F. Galloway  
G. F. Galloway 107 Rule Building  
(Address)

SUBSCRIBED AND SWORN TO before me this 14th day of November, 19 56

My commission expires May 20, 1959

Vicky Jacobs  
Vicky Jacobs  
Notary Public.

PLUGGING  
FILE SEC 25 T. 2 R. 23W  
BOOK PAGE 116 LINE 20

RECEIVED  
CONSERVATION COMMISSION  
NOV 15 1956  
11-15-56  
CONSERVATION DIVISION  
Wichita, Kansas

15-137-00628-00-00

CONTRACTOR'S WELL LOG

OPERATOR C-G DRILLING CO. WELL NAME SANDERS #1

LOCATION SE SE SE SECTION 25-2-23W RIG NO. 1

COUNTY NORTON STATE KANSAS

COMMENCEMENT DATE NOVEMBER 5, 1956 COMPLETION DATE NOVEMBER 11, 1956

LOG OF WELL

Elevation 2242' rotary bushing.  
 All measurements taken from the top of rotary bushing.

| FROM | TO   | FORMATION  | DEVIATION FROM VERTICAL | REMARKS |
|------|------|------------|-------------------------|---------|
| 0    | 700  | Shale-Sand |                         |         |
| 700  | 1430 | Sand-Shale |                         |         |
| 1430 | 1680 | Sand       |                         |         |
| 1680 | 1812 | Red Bed    |                         |         |
| 1812 | 1850 | Anhydrite  |                         |         |
| 1850 | 2000 | Lime-Shale |                         |         |
| 2000 | 2410 | Lime-Shale |                         |         |
| 2410 | 2670 | Lime-Shale | 0° - 2500               |         |
| 2670 | 2830 | Lime-Shale | 0° - 2750               |         |
| 2830 | 3010 | Lime-Shale | 0° - 3000               |         |
| 3010 | 3120 | Lime-Shale |                         |         |
| 3120 | 3340 | Lime-Shale | 0° - 3250               |         |
| 3340 | 3407 | Lime-Shale |                         |         |
| 3407 | 3526 | Lime-Shale | 0° - 3500               |         |
| 3526 | 3570 | Lime-Shale |                         |         |
| 3570 | 3632 | Lime-Shale |                         |         |

CASING LEFT IN HOLE AFTER COMPLETION

Ran 308' (15 jts) 8-5/8" OD Surface Casing

STATE OF KANSAS }  
 COUNTY OF SEDGWICK } SS.

The undersigned hereby certifies that to the best of his knowledge and belief, the above facts are true and correct.

C-G DRILLING CO.  
 By G. F. Galloway  
 G. F. Galloway

Subscribed and sworn to before me this 14th day of November, 1956.

My commission expires:  
May 20, 1959

Vicky Jacobs  
 Vicky Jacobs, Notary Public

PLUGGING  
 FILE SEC 25 T 2 S 23W  
 BOOK PAGE 116 LINE 20

RECEIVED  
 STATE CORPORATION COMMISSION  
 NOV 15 1956  
 CONSERVATION DIVISION  
 Wichita, Kansas