

15-137-00166-0000


STATE OF KANSAS
STATE CORPORATION COMMISSION

Give All Information Completely
Make Required Affidavit
Mail or Deliver Report to:
Conservation Division
State Corporation Commission
212 North Market, Insurance Bldg.
Wichita, Kansas

WELL PLUGGING RECORD

Norton County, Sec. 23 Twp. 2 Rge. 23 (E) W (W)

Location as "NE/CNW/SW" or footage from lines SE 1/4 SE 1/4 SW 1/4
Lease Owner Birmingham-Bartlett Drilling Co.
Lease Name Beckman Well No. 1
Office Address Wichita, Kansas 300 Kaufman Bldg.
Character of Well (completed as Oil, Gas or Dry Hole) Dry hole OIL
Date well completed June 6 1961
Application for plugging filed Sept 15 1961
Application for plugging approved Sept. 21, 1961
Plugging commenced Sept. 16 1961
Plugging completed Sept. 20 1961
Reason for abandonment of well or producing formation Oil Depleted

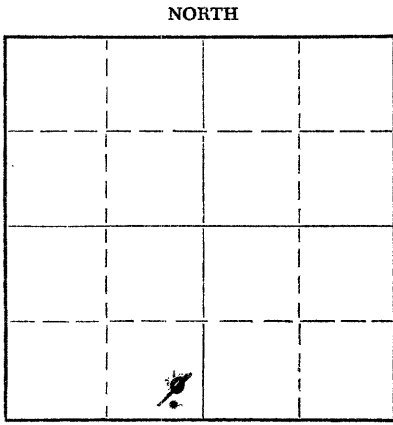

Locate well correctly on above Section Plat

If a producing well is abandoned, date of last production Aug. 30 1961
Was permission obtained from the Conservation Division or its agents before plugging was commenced? yes

Name of Conservation Agent who supervised plugging of this well Eldon Petty
Producing formation _____ Depth to top _____ Bottom _____ Total Depth of Well 3690 Feet
Show depth and thickness of all water, oil and gas formations.

OIL, GAS OR WATER RECORDS

CASING RECORD

FORMATION	CONTENT	FROM	TO	SIZE	PUT IN	PULLED OUT
				5 1/2"	3668'	3043'
				8 5/8"	244'	none

Describe in detail the manner in which the well was plugged, indicating where the mud fluid was placed and the method or methods used in introducing it into the hole. If cement or other plugs were used, state the character of same and depth placed, from _____ feet to _____ feet for each plug set.

Plugged back with sand from 3690' to 3655'. Mixed and dumped 4 sx. cement from 3655 to 3623'. Pulled pipe to 500'. Circulated 20 sx. gel mud. Mixed and pumped in 20 sx. cement from 500' to 440'. Pulled pipe to 180'. Mixed and pumped in 20 sx. cement from 180' to 120'. Pulled rest of casing. Bailed off gel to 35'. Set 5' rock bridge from 35' to 30'. Mixed and dumped 10 sx. cement from 30' to base of cellar.

STATE CORPORATION COMMISSION

OCT 3 1961

CONSERVATION DIVISION

10-3-61

(If additional description is necessary, use BACK of this sheet)

Name of Plugging Contractor Ace Pipe Pulling Company
Address Box 304 Great Bend, Kansas License # 2

STATE OF Kansas, COUNTY OF Sedgwick, SS.
Chas. Keevert, Prod. Supt. of Birmingham-Bartlett Drilling Co. owner & operator
well, being first duly sworn on oath, says: That I have knowledge of the facts, statements, and matters herein contained and the log of the above-described well as filed and that the same are true and correct. So help me God.

(Signature) Chas. H. Keevert
Wilson Rd., Route 1, Hutchinson, Kans
(Address)

SUBSCRIBED AND SWORN TO before me this 2nd day of October, 19 61

My commission expires November 29, 1962
Vivian F. Yinger
Vivian F. Yinger, Notary Public.



9-11-61

RECEIVED
STATE CORPORATION COMMISSION

SEP 11 1961

CONSERVATION DIVISION
Wichita, Kansas

BECKMAN NO. 1 WELL

LOCATION: SE/4 SE/4 SW/4
Section 23-25-23N
Horton County, Kansas

SPUNDED: 5-31-61
COMPLETED: 6-6-61

OWNER, OPERATOR
and CONTRACTOR: Birmingham-Bartlett Drilling Co.
300 Kaufman Building
Wichita 2, Kansas

SURFACE CASING: 8-5/8" casing cemented at 244'
with 150 sacks cement

OIL STRING: 5-1/2" O.D. 14# J-55-R-2 snls casing
cemented at 3673' with 100 sacks
cement

LOG

(Figures indicate bottom of formation)

0 - 100	Clay and sand
244	Shale
1250	Shale and shells
1400	Sand
1600	Shale and shells
1945	Sand and red bed
1974	Anhydrite
2370	Shale and shells
2905	Shale and lime
2993	Shale and shells
3673	Lime and shale
3673	Rotary total depth

The undersigned, Richard Hindery, one of the partners of Birmingham-Bartlett Drilling Co., hereby certifies that the above is a true and correct log of the Beckman No. 1 Well as shown in the daily drilling reports.

BIRMINGHAM-BARTLETT DRILLING CO.

By Richard Hindery
Richard Hindery, Partner

Subscribed and sworn to before me
this 9th day of June, 1961.

Beverly Larson

Beverly Larson, Notary Public
My commission expires October 2, 1962.