


15-137-00187-00-00

STATE OF KANSAS
STATE CORPORATION COMMISSION

Give All Information Completely
Make Required Affidavit
Mail or Deliver Report to:
Conservation Division
State Corporation Commission
800 Bitting Building
Wichita, Kansas

WELL PLUGGING RECORD

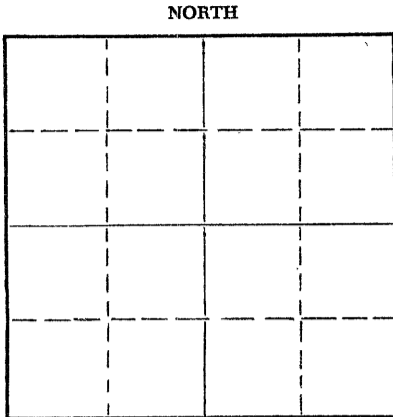

Locate well correctly on above
Section Plat

NORTON County. Sec. 9 Twp. 2 Rge. 23 (E)W" (W)
Location as "NE/CNW/SW" or footage from lines NW NW NE
Lease Owner EMPIRE DRILLING COMPANY
Lease Name WALLACK Well No. 1
Office Address 407 BROWN BUILDING, WICHITA 2, KANSAS
Character of Well (completed as Oil, Gas or Dry Hole) DRY HOLE
Date well completed 5-23-55 19
Application for plugging filed 5-23-55 19
Application for plugging approved 5-23-55 19
Plugging commenced 5-23-55 19
Plugging completed 5-23-55 19
Reason for abandonment of well or producing formation DRY HOLE

If a producing well is abandoned, date of last production 19
Was permission obtained from the Conservation Division or its agents before plugging was commenced? YES

Name of Conservation Agent who supervised plugging of this well ELDON PETTY
Producing formation Depth to top Bottom Total Depth of Well 3755 Feet
Show depth and thickness of all water, oil and gas formations.

OIL, GAS OR WATER RECORDS

CASING RECORD

FORMATION	CONTENT	FROM	TO	SIZE	PUT IN	PULLED OUT
SURFACE		0	173'	8 5/8"	173'	0

Describe in detail the manner in which the well was plugged, indicating where the mud fluid was placed and the method or methods used in introducing it into the hole. If cement or other plugs were used, state the character of same and depth placed, from feet to feet for each plug set.

FIRST PLUG @ 170' WITH 1/2 SACK HULLS AND 15 SACKS OF CEMENT
TOP PLUG @ 40' WITH 1/2 SACK HULLS AND 10 SACKS OF CEMENT

RECEIVED
STATE CORPORATION COMMISSION

JUN 3 - 1955 6-3-55

CONSERVATION DIVISION
Wichita, Kansas

RECEIVED
STATE CORPORATION COMMISSION

JUN 2 1955

CONSERVATION DIVISION
Wichita, Kansas

(If additional description is necessary, use BACK of this sheet)

Name of Plugging Contractor EMPIRE DRILLING COMPANY
Address 407 BROWN BUILDING, WICHITA 2, KANSAS

STATE OF KANSAS, COUNTY OF SEDGWICK, ss.
I, DAN J. KORNFELD (employee of operator) of the above-described well, being first duly sworn on oath, says: That I have knowledge of the facts, statements, and matters herein contained and the log of the above-described well as filed and that the same are true and correct. So help me God.

(Signature) Dan J. Kornfeld
DAN J. KORNFELD
407 BROWN BUILDING, WICHITA 2, KANSAS
(Address)

SUBSCRIBED AND SWORN TO before me this 26TH day of MAY, 1955

[Signature]
Notary Public.

My commission expires DECEMBER 10, 1956

PLUGGING
721 MC 9 12 23A
BOOK PAGE 122 LINE 27

15-137-00187-00-00

L O G

COMPANY: D. L. SOMERS & EMPIRE DRILLING COMPANY

CONTRACTOR: EMPIRE DRILLING COMPANY

FARM: WALLACK #1

LOCATION: NW NW NE, SEC. 9-2-23
NORTON COUNTY, KANSAS

COMMENCED: 5-16-55

COMPLETED: 5-23-55

0	TO	190	SURFACE
190	TO	1090	SHALE AND SAND
1090	TO	1984	SHALE AND SHELLS
1984	TO	2014	ANHYDRITE
2014	TO	2570	SHALE AND SHELLS
2570	TO	3300	LIME AND SHALE
3300	TO	3405	LIME
3405	TO	3610	LIME AND SHALE
3610	TO	3687	LIME
3687	TO	3690	SHALE
3690	TO	3718	ARBUCKLE
3718	TO	3755	GRANITE WASH
3755			R.T.D.

SET 8 5/8" SURFACE CASING AT 173' WITH 115 SACKS OF CEMENT

ELEVATION: 2423 K.B.

TOPS: ANHYDRITE 1984'; HEEBNER 3408'; TORONTO 3440'; LANSING K.C. 3454'; BASE K.C. 3635'; ARBUCKLE 3690'; GRANITE WASH 3718'; R.T.D. 3755'

D & A

RECEIVED
6-2-55

C E R T I F I C A T I O N

I, DAN J. KORNFELD, DO HEREBY CERTIFY THAT THE ABOVE AND FOREGOING IS A TRUE AND CORRECT COPY OF THE LOG ON THE #1 WALLACK, NW NW NE, SECTION 9, TOWNSHIP 2 SOUTH RANGE 23 WEST, NORTON COUNTY, KANSAS, AS REFLECTED BY THE FILES OF THE EMPIRE DRILLING COMPANY.

Dan J. Kornfeld
DAN J. KORNFELD

SUBSCRIBED AND SWORN TO BEFORE ME A NOTARY PUBLIC WITHIN AND FOR SEDGWICK COUNTY, KANSAS, THIS 26TH DAY OF MAY, 1955.

MY COMMISSION EXPIRES DECEMBER 10, 1956

J. Valentine Jr.
NOTARY PUBLIC

PLUGGING
FILE SEC 9 T 2 R 23W
PAGE 122 LINE 27