


15-137-00176-00-00

Give All Information Completely
Make Required Affidavit
Mail or Deliver Report to:
Conservation Division
State Corporation Commission
212 North Market, Insurance Bldg.
Wichita, Kansas

WELL PLUGGING RECORD

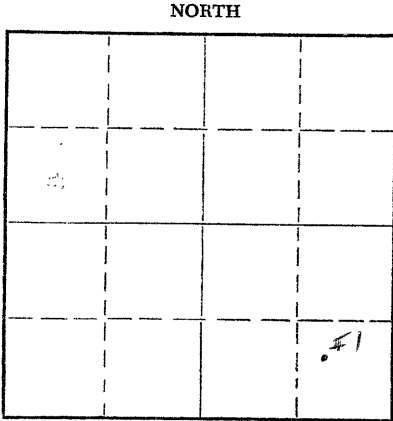

Locate well correctly on above Section Plat

Norton County. Sec. 3 Twp. 2S Rge. 23W (E) (W)
Location as "NE/CNW/SW" or footage from lines 990' from South & East lines SE
Lease Owner Sinclair Oil & Gas Company
Lease Name Nina Melroy Well No. 1
Office Address Box 521, Tulsa, Oklahoma
Character of Well (completed as Oil, Gas or Dry Hole) Dry Hole
Date well completed 8-3-61 19__
Application for plugging filed 8-3-61 19__
Application for plugging approved 8-11-61 19__
Plugging commenced 8-3-61 19__
Plugging completed 8-3-61 19__
Reason for abandonment of well or producing formation Dry Hole

If a producing well is abandoned, date of last production _____ 19__
Was permission obtained from the Conservation Division or its agents before plugging was commenced? Yes

Name of Conservation Agent who supervised plugging of this well Eldon Petty
Producing formation None Depth to top _____ Bottom _____ Total Depth of Well 3773' Feet
Show depth and thickness of all water, oil and gas formations.

OIL, GAS OR WATER RECORDS

CASING RECORD

FORMATION	CONTENT	FROM	TO	SIZE	PUT IN	PULLED OUT
None Encountered						

Describe in detail the manner in which the well was plugged, indicating where the mud fluid was placed and the method or methods used in introducing it into the hole. If cement or other plugs were used, state the character of same and depth placed, from _____ feet to _____ feet for each plug set.
Mudded hole from TD 3773' to 540', spotted 20 sacks cement from 540' to 480', Mudded from 480' to 180', spotted 20 sacks cement from 180' to 100', mudded hole from 100' to surface with 10 sacks cement cap on top of hole. Hole plugged as per Mr. Eldon Petty, State Inspector's instructions.

RECEIVED
STATE CORPORATION COMMISSION

AUG 21 1961

CONSERVATION DIVISION
Wichita, Kansas

8-21-61

(If additional description is necessary, use BACK of this sheet)
Name of Plugging Contractor National Drilling Company
Address 535 Petroleum Bldg., Wichita, Kansas

STATE OF Kansas, COUNTY OF Rice, ss.
C. E. Most (employee of owner) or (owner or operator) of the above-described well, being first duly sworn on oath, says: That I have knowledge of the facts, statements, and matters herein contained and the log of the above-described well as filed and that the same are true and correct. So help me God.

(Signature) C. E. Most Dist. Supt.
P. O. Box 466, Chase, Kansas
(Address)

SUBSCRIBED AND SWORN TO before me this 18th day of August, 19 61

My commission expires August 13, 1962
L. B. Reynolds Notary Public.



15-137-00476-00-00

KANSAS GEOLOGICAL SOCIETY
KANSAS WELL LOG BUREAU - KANSAS WELL SAMPLE BUREAU
KANSAS GEOLOGICAL SOCIETY BUILDING
508 EAST MURDOCK - WICHITA, KANSAS

COMPANY *Sinclair Oil & Gas Company*
FARM *Nina Melroy* NO. *1*

SEC. *3* T. *2S* R. *23W*
LOC. *NW SE SE*

TOTAL DEPTH *3775*
COMM. *7-25-61* COMP. *8-2-61*
SHOT OR TREATED
CONTRACTOR *National Drilling Company, Inc.*
ISSUED

COUNTY *Norton*
KANSAS

CASING
20 10
15 8 -5/8 *337' @ 330/w 240 sks cement*
12 6 *14 sacks HA-5 Added*
13 5

ELEVATION *2396 K.B.*
PRODUCTION *D & A*

FIGURES INDICATE BOTTOM OF FORMATIONS

- Clay* 25
- Sand* 150
- Sand* 200
- ~~*XXX*~~
- Shale* 335
- Shale & Shells* 1150
- Sand & Shale* 1450
- Sand & Shale* 1750
- Shale & Shells* 1952
- Anhydrite* 1985
- Shale & Shells* 2375
- Shale & Shells* 2480
- Lime & Shale* 2580
- Lime & Shale* 2800
- Lime & Shale* 2880
- Lime & Shale* 3025
- Lime & Shale* 3130
- Lime & Shale* 3210
- Lime & Shale* 3360
- Lime & Shale* 3472
- Lime* 3500
- Lime* 3543
- Lime* 3613
- Lime & Shale* 3895
- Lime & Shale* 3735
- Lime* 3765
- Granite Wash* 3775

RECEIVED
STATE CORPORATION COMMISSION

AUG 21 1961

CONSERVATION DIVISION
Wichita, Kansas

8-21-61

I hereby certify that this is a true and correct log of the above described well as shown by the drilling reports.

NATIONAL DRILLING COMPANY, INC.

Howard A. Stoskopf
Howard A. Stoskopf

STATE OF KANSAS)
SEDGWICK COUNTY)

Subscribed and sworn to before me, a Notary Public, in and for said County and State this 7th day of August, 1961.

Notary Public
Notary Public

My Commission Expires:

May 31, 1961