

19-137-00026-00-00

STATE OF KANSAS
STATE CORPORATION COMMISSION


WELL PLUGGING RECORD

OR
FORMATION PLUGGING RECORD

Strike out upper line
when reporting plug-
ging off formations.

Give All Information Completely
Make Required Affidavit
Mail or Deliver Report to:
Conservation Division
State Corporation Commission
800 Bittig Building
Wichita, Kansas

Norton County. Sec. 3 Twp. 2S Rge. (E) 22 (W)
Location as "NE $\frac{1}{4}$ NW $\frac{1}{4}$ SW $\frac{1}{4}$ " or footage from lines NE $\frac{1}{4}$ NE $\frac{1}{4}$ SW $\frac{1}{4}$
Lease Owner. Sohio Petroleum Company
Lease Name. Reeves Well No. 1
Office Address. Russell, Kansas - Box 609
Character of Well (completed as Oil, Gas or Dry Hole) Dry Hole
Date well completed. October 25, 19 46
Application for plugging filed. October 26, 19 46
Application for plugging approved. October 26, 19 46
Plugging commenced. October 26, 19 46
Plugging completed. October 26, 19 46
Reason for abandonment of well or producing formation. Too low to produce

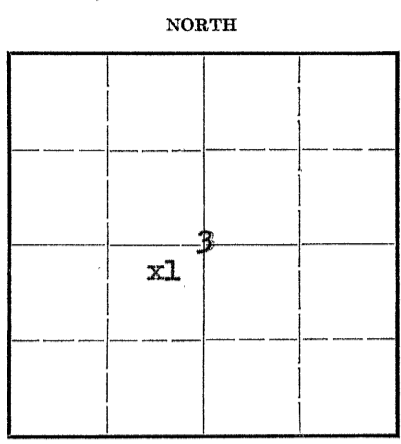

Locate well correctly on above
Section Plat

If a producing well is abandoned, date of last production. 19
Was permission obtained from the Conservation Division or its agents before plugging was com-
menced? Yes, by telephone from Mr. Herb Kerr

Name of Conservation Agent who supervised plugging of this well Mr. Herb Kerr
Producing formation. None Depth to top. Bottom. Total Depth of Well 3753 Feet
Show depth and thickness of all water, oil and gas formations.

OIL, GAS OR WATER RECORDS

CASING RECORD

Formation	Content	From	To	Size	Put In	Pulled Out
<u>No commercial oil nor gas shows from top of hole to total depth</u>				<u>10-3/4"</u>	<u>196</u>	<u>None. Cemented with 250 sacks</u>

Describe in detail the manner in which the well was plugged, indicating where the mud fluid was placed and the method or methods used in introducing it into the hold. If cement or other plugs were used, state the character of same and depth placed, from _____ feet to _____ feet for each plug set.

Heavy Mud 3753' to 196'
Cement - 15 Sacks 196' to 166'
Heavy Mud 166' to 20'
Cement 20' to base of cellar
Clay to surface

3 2 22W
78 44
Rec'D
10-30-46

(If additional description is necessary, use BACK of this sheet)

Correspondence regarding this well should be addressed to Sohio Petroleum Company
Address Box 609, Russell, Kansas

STATE OF Kansas, COUNTY OF Russell, ss.
P. C. Musgrave (employee of owner) or (owner or operator) of the above-described well,
being first duly sworn on oath, says: That I have knowledge of the facts, statements, and matters herein contained and the log of the above-described well as filed and that the same are true and correct. So help me God.

(Signature) P. C. Musgrave

(Address)

SUBSCRIBED AND SWORN to before me this 29th day of October, 19 46
Bernie J. Smith
Notary Public.

My commission expires May 8, 1948.

My commission expires



SOHIO PETROLEUM COMPANY
PRODUCTION DEPARTMENT

KANSAS DISTRICT
P. C. MUSGROVE, SUPERINTENDENT

BOX 609
RUSSELL, KANSAS

October 28, 1946

Kansas State Corporation Commission,
800 Bitting Building,
Wichita,
Kansas.

Gentlemen:


Attached are the following forms on Sohio's Reeves #1,
NE NE SW 3-2S-22W, Norton County, Kansas:

Well Plugging Application Form
Well Plugging Record

Very truly yours,

P. C. Musgrove
P. C. Musgrove

ab
Encls. 2

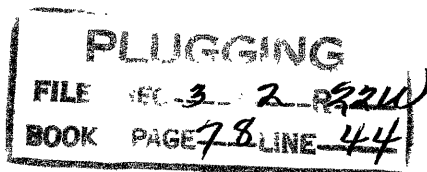

10-30-46

CONTRACTOR'S VERIFIED LOG

Operator Sohio Petroleum Co. Farm Name Reeves Well No. 1
 Location NE NE SW Sec. 3-2S-22W, Northn County, Kansas
 Pool Name Wildcat County Norton State Kansas
 Commencement Date 10-14-46 Completion Date 10-36-46

LOG OF WELL

Depth		Formation	Deviation from Vertical (Degrees)	Remarks
From	To			
0	90	Clay		
90	110	Sand		
110	189	Shale & sand		10" Casing @ 189'
189	1880	Shale & shells	0°	
1880	2015	Shale and lime	0°	
2015	2168	Shale		
2168	2275	Shale & shells		
2275	2480	Shale & lime		
2480	2795	Shale & shells	0°	
2795	2855	Shale & lime		
2855	3010	Shale & shells	0°	
3010	3093	Shale		
3093	3235	Shale & shells		
3235	3415	Shale & lime		
3415	3426	Shale		
3426	3512	Kansas City lime	0°	
3512	3636	Lime & shale		
3636	3704	Shale		
3704	3750	Arbuckle lime		
3750	3755	Granite		Dry and abandoned

PLUGGING
 FILE REC-3 T-2 R-22W
 BOOK PAGE 78 LINE 44

5-19-47

