

15-147-00136-00-00


STATE OF KANSAS
STATE CORPORATION COMMISSION

Give All Information Completely
Make Required Affidavit
Mail or Deliver Report to:
Conservation Division
State Corporation Commission
212 North Market, Insurance Bldg.
Wichita, Kansas

WELL PLUGGING RECORD

Phillips County. Sec. 28 Twp. 2S Rge. (E) 20 (W)

Location as "NE/CNW/SW" or footage from lines C NW NE
Lease Owner NATIONAL ASSOCIATED PETROLEUM CO.
Lease Name VAN DIEST Well No. 1
Office Address Fifth Floor Ritz Bldg., Tulsa, Oklahoma
Character of Well (completed as Oil, Gas or Dry Hole) Dry hole
Date well completed July 26 19 61
Application for plugging filed July 26 19 61
Application for plugging approved July 26 19 61
Plugging commenced July 26 19 61
Plugging completed July 26 19 61
Reason for abandonment of well or producing formation Dry hole

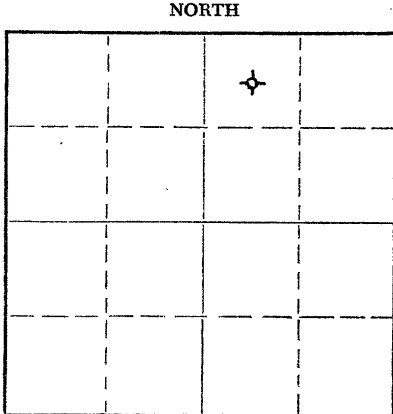

Locate well correctly on above
Section Plat

If a producing well is abandoned, date of last production _____ 19____
Was permission obtained from the Conservation Division or its agents before plugging was commenced? Yes

Name of Conservation Agent who supervised plugging of this well Eldon Petty
Producing formation _____ Depth to top _____ Bottom _____ Total Depth of Well 4051 Feet
Show depth and thickness of all water, oil and gas formations.

OIL, GAS OR WATER RECORDS

CASING RECORD

FORMATION	CONTENT	FROM	TO	SIZE	PUT IN	PULLED OUT
	Lansing DST			8 5/8"	212'	None
	3518-52: Rec.					
	15' sl. OCM,					
	180' mud, sl.					
	water cut.					
	Sl. scum oil.					

Describe in detail the manner in which the well was plugged, indicating where the mud fluid was placed and the method or methods used in introducing it into the hole. If cement or other plugs were used, state the character of same and depth placed, from _____ feet to _____ feet for each plug set.

Plug @ 240' w/25 sx cement
Plug @ 40' w/10 sx cement

RECEIVED
STATE CORPORATION COMMISSION
AUG 3 1961
CONSERVATION DIVISION
Wichita, Kansas

8-3-61

(If additional description is necessary, use BACK of this sheet)

Name of Plugging Contractor K & E DRILLING, INC.
Address 719 Union Center Bldg., Wichita, Kansas

STATE OF KANSAS, COUNTY OF SEDGWICK, ss.
H. L. Wilson (employee of owner) or (~~owner or operator~~) of the above-described well, being first duly sworn on oath, says: That I have knowledge of the facts, statements, and matters herein contained and the log of the above-described well as filed and that the same are true and correct. So help me God.

(Signature) H. L. Wilson
H. L. Wilson, K & E Drilling, Inc.
719 Union Center, Wichita, Kansas
(Address)

SUBSCRIBED AND SWORN TO before me this 31st day of July, 19 61

My commission expires October 30, 1961
Wildalee Wind Notary Public.



15-147-00136-00-00

DRILLER'S WELL LOG

OPERATOR: NATIONAL ASSOCIATED PETROLEUM CO. WELL NAME: #1 VAN DIEST
Fifth Floor Ritz Building
Tulsa, Oklahoma

LOCATION: C NW NE
Sec. 28-2S-20W
Phillips County, Kansas

CONTRACTOR: **K & E DRILLING, INC.**
719 UNION CENTER BLDG.
WICHITA, KANSAS

COMMENCED: July 18, 1961

CASING RECORD: 8 5/8" @ 212' w/150 sx

COMPLETED: July 26, 1961

ELEVATION: 2238 K.B.

ROTARY TOTAL DEPTH: 4051'

PRODUCTION: Dry

FORMATION RECORD

Depths shown indicate bottom of formations encountered.

Soil and clay	65
Sand	100
Clay and shale	215
Clay and shale	390
Shale and pyrite	650
Shale and sand	1170
Sand	1914
Shale	1929
Anhydrite	1954
Shale and lime	2270
Lime and shale	2786
Lime	2985
Lime and shale	3148
Lime	3352
Lime, sand and shale	3446
Lime	3552
Lime and shale	3583
Lime	3703
Lime and shale	3860
Lime	3984
Lime and granite	4051 RTD

RECEIVED
STATE CORPORATION COMMISSION

AUG 3 1961

CONSERVATION DIVISION
Wichita, Kansas

8-3-61

CERTIFICATION

State of KANSAS }
County of SEDGWICK } ss:

I, H. L. Wilson, of K&E DRILLING, INC., upon oath state that the above and foregoing is a true and correct copy of the Driller's Log of the above named well.

H. L. Wilson
H. L. Wilson

Subscribed and sworn to before me this 31st day of June, 19 61.

Wildalee Wind
Wildalee Wind - Notary Public.

My Commission expires: October 30, 1961.

