

CARD MUST BE TYPED

State of Kansas  
**NOTICE OF INTENTION TO DRILL**  
(see rules on reverse side)

CARD MUST BE SIGNED

Starting Date: 10 22 84  
month day year

API Number 15- 137-20,344-00-00

OPERATOR: License # 5011

W/2 E/2 SW... Sec 33, Twp 2 S, Rge 23  East  West  
(location)

Name Viking Resources

Address 217 E. William

City/State/Zip Wichita, KS 67202-4005

Contact Person Jim Devlin

Phone 316-262-2502

1320 Ft North from Southeast Corner of Section

3630 Ft West from Southeast Corner of Section

(Note: Locate well on Section Plat on reverse side)

CONTRACTOR: License # 5420

Nearest lease or unit boundary line 330 feet.

County Norton

Name White and Ellis Drilling, Inc.

Lease Name LeCount Well# 1

City/State Wichita, KS 67202-3484

Domestic well within 330 feet:  yes  no

Municipal well within one mile:  yes  no

Well Drilled For: Well Class: Type Equipment:

- |   |                               |   |  |
|---|-------------------------------|---|--|
| <input checked="" type="checkbox"/> Oil | <input type="checkbox"/> Swd  | <input type="checkbox"/> Infield              | <input checked="" type="checkbox"/> Mud Rotary |
| <input type="checkbox"/> Gas            | <input type="checkbox"/> Inj  | <input checked="" type="checkbox"/> Pool Ext. | <input type="checkbox"/> Air Rotary            |
| <input type="checkbox"/> OWWO           | <input type="checkbox"/> Expl | <input type="checkbox"/> Wildcat              | <input type="checkbox"/> Cable                 |

Depth to Bottom of fresh water 150 feet

Lowest usable water formation Dakota

Depth to Bottom of usable water 1125 feet

Surface pipe by Alternate: 1  2

Surface pipe to be set 240+ feet

Conductor pipe if any required None feet

Ground surface elevation 2320 Est. feet MSL

This Authorization Expires 4-12-85

Approved By 10-12-84 *[Signature]*

If OWWO: old well info as follows:

Operator

Well Name

Comp Date Old Total Depth

Projected Total Depth 3625 feet

Projected Formation at TD Reagan

Expected Producing Formations LKC

I certify that we will comply with K.S.A. 55-101, et seq., plus eventually plugging hole to K.C.C. specifications.

Date 11 October 1984

Signature of Operator or Agent

*[Signature]*


Title

Operator

**Must be filed with the K.C.C. five (5) days prior to commencing well  
This card void if drilling not started within six (6) months of date received by K.C.C.**

**Important procedures to follow :**

**A Regular Section of Land  
1 Mile = 5,280 Ft.**

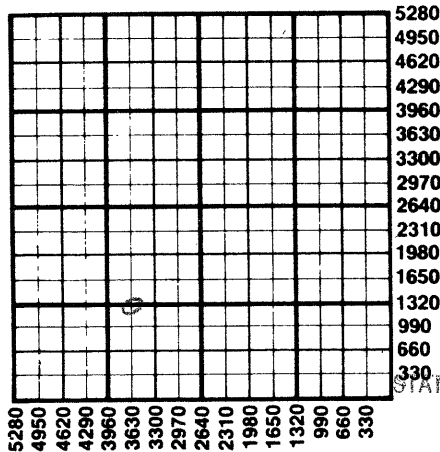

1. Notify District office before setting surface casing.
2. Set surface casing by circulating cement to the top.
3. File completion forms ACO-1 with K.C.C. within 90 days of well completion, following instructions on ACO-1, side 1, and including copies of wireline logs.
4. Notify District office 48 hours prior to old well workover or re-entry.
5. Prior to plugging, prepare a plugging plan, then obtain agreement from the appropriate district office for an approved plugging plan.
6. Submit plugging report (CP-4) to K.C.C. after plugging is completed.
7. Obtain an approved injection docket number before disposing of salt water.
8. Notify K.C.C. within 10 days when injection commences or terminates.

9. If an alternate 2 completion, cement in the production pipe from below any reasonable water to surface within 120 days of spud date.

RECEIVED

STATE CORPORATION COMMISSION

OCT 12 1984  
10-12-84  
CONSERVATION DIVISION  
Wichita, Kansas

**State Corporation Commission of Kansas  
Conservation Division  
200 Colorado Derby Building  
Wichita, Kansas 67202  
(316) 263-3238**